IREDELL COUNTY HEALTH DEPARTMENT

Statesville Phone TR 3-7271 — Mooresville Phone NO 3-1271

PERMIT TO INSTALL SEPTIC TANK

Permit No. 107 — Permit Date 6--6 1972

Owner KENNETH WOOTEN — Address STATESVILLE, NC.

Installed By ORBISON — Address MOORESVILLE, NC.

Location of Property 70 E- RIGHT ON Rd #2354


SUBURBAN ACRES. LOT #9

Tank		Capacity		Length of Lines		Fixtures	
Block	( )	1000	( )	225'	( )	No. of Baths	(2)
Precast	(✓)	1250	(✓)	250'	( )	Dishwasher	( )
		1500	( )	Other 425		Garbage Grdr.	( )
		Other		1020 sq ft + Extra Stone		Other	

NOTIFY HEALTH DEPARTMENT AT LEAST EIGHT HOURS BEFORE TANK IS TO BE INSPECTED.

Final Inspection 6 - 6 1972 — Approved (✓) Disapproved ( )

Remarks COMMUNITY WATER SUPPLY -

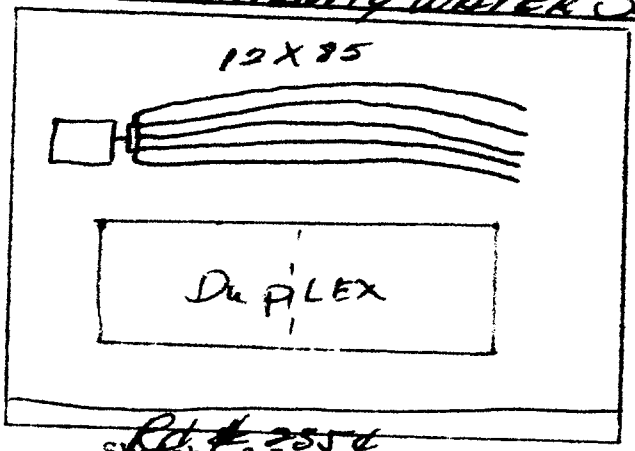

Sketch of Installation

System near Bank may leach out.

Glenn Lord

Sanitarian