ICHD - ENVIRONMENTAL HEALTH DIVISION

Statesville Office (704) 878-5305 x3456 Mooresville Office (704) 660-3625

SEPTIC: IMPROVEMENT PERMIT / AUTHORIZATION TO CONSTRUCT / OPERATION PERMIT / EXISTING SYSTEM

H5

PERMIT: OSWP 2024-56268

PIN #4753-45-7119

APPLICANT/OWNER: Amy Mistler | APPLICANT ADDRESS: 206 State Park Rd Troutman, NC 28166

SITE ADDRESS: 145 Third Creek Rd Statesville, NC 28677 | PHONE: (704)252-0627 | ALT. PHONE

SITE DIRECTIONS: N Center St, US-70E, Third Creek | SAP CONTROLLED: ☐ YES ☑ NO

SUBDIVISION: Suburban Acres | SECTION: | LOT # C | LOT AREA: | DESIGN FLOW: Ext | L.T.A.R.(Initial): Ext | L.T.A.R (Repair): Ext

Septic Tank 1000 (gal) STB 1012 Date 4/28/24

Pump Tank (gal) PT Date

Pump Make Model Serial #

Nitrification Fields Ext # Lines Ext Linear Ft Ext

Trench Width Ext *Max. Trench Depth(Initial) Ext *Max. Trench Depth(Repair) Ext Gravel Depth Ext

* Measured on the downhill side of the trench

☐ New System ☑ Repair ☐ Expansion System Type: I II III IV V VI

System Description:

Repair System Description: Tank Replacement

Maintenance Agreement Required: ☐ YES ☑ NO

☑ GRAVITY ☐ PRESSURE

Effluent Standard: ☑ DSE ☐ HSE ☐ TS-I ☐ TS-II ☐ RCW ☐ NSF/ANSI 40

Usable Depth to LC (Initial): Ext

☑ Residence No. Bedrooms 3

☐ Business No. Persons 6

☐ Other No. Employees

☐ Slab ☐ Crawl Space

☐ Basement w/plumbing ☐ Basement w/o plumbing

Usable Depth to LC (Repair): Ext *Limiting Condition*

Water Supply


☐ Private

☑ Public

☐ Community

Comments / Conditions: Dump, crush, fill existing cracked tank. Place new tank where proper fall can be achieved.

INITIAL SITE SKETCH

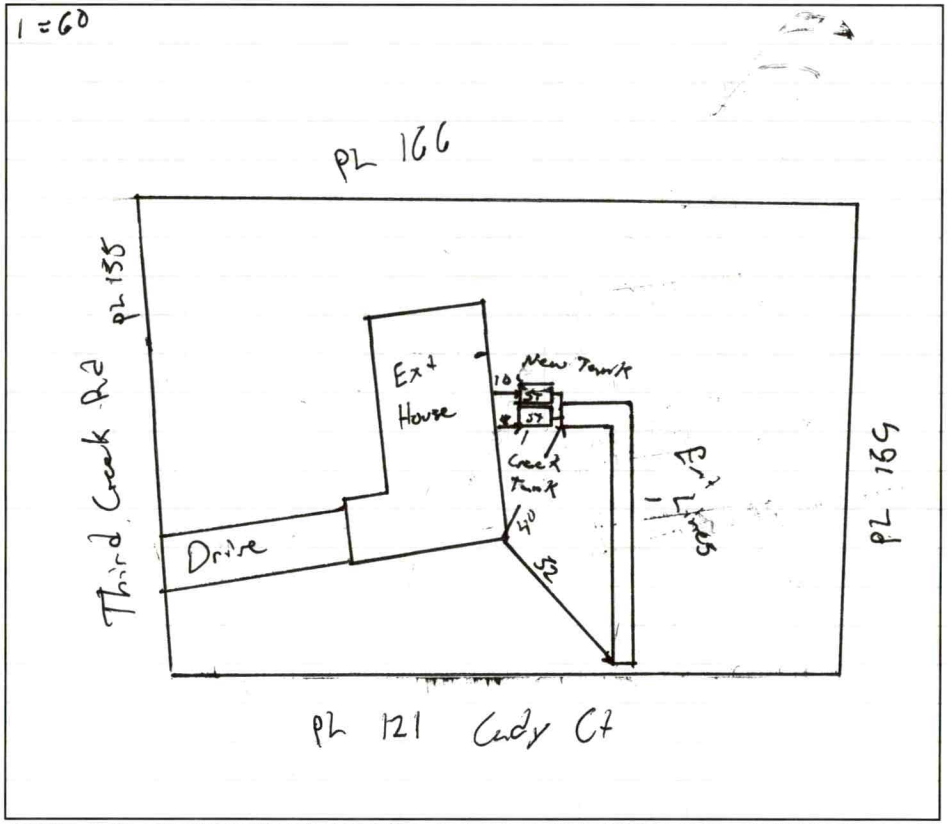

AS BUILT SKETCH

FOR SEPTIC FINAL INSPECTION CALL: 704-664-3703 between 8am-9am the day the inspection is needed. Be sure to speak with an inspector to confirm your time.

Installed as Drawn

Permit can be suspended or revoked if any false information is supplied toward securing the permit / any unauthorized changes are made to the site / any unauthorized changes are made in the installation of the system. **CONTACT A LOCATOR SERVICE PRIOR TO ANY EXCAVATION**

☐ **IMPROVEMENT PERMIT** ***with plat*** *valid without expiration.* ☑ **IMPROVEMENT PERMIT** ***with site plan*** *valid for 60 mos.* ☑ **AUTHORIZATION TO CONSTRUCT** *valid for period equal to IMPROVEMENT PERMIT--not to exceed 60 mo.*

Owner / Applicant Signature: On line Signature Date:

Installed by: Kevin Powell

IMPROVEMENT PERMIT by: Matt Wi ✓ Date: 7/2/24

OPERATION PERMIT by: Cy Hil ✓ Date: 7/25/24

AUTHORIZATION TO CONSTRUCT by: Matt Wi ✓ Date: 7/2/24

Existing System Inspected by: Date:

Item	Date	Initials
Drain Lines Checked		
Tanks Checked		
Pressure Manifold or Valve Box Checked		
Pressure Head Set		
Electrical Checked		
Floats Set		
Alarm Checked		
Maintenance Contract Needed? Y / N		
Comments:		

Repairs Only	
	State Code
Failing System Code	
Type of Distribution	G or P
Type of Failure/Malfunction	
Primary Cause of Failure/Malfunction	
Age of System? _____	
Initial or Repair? _____	

PERMIT SNAPSHOT REPORT OSWP-2024-56268 FOR IREDELL COUNTY

Permit Type	Environmental Health OSWP	**Project:**		**App Date:**	06/24/2024
Work Class:	EH Septic Permit	**District:**	Statesville	**Exp Date:**	NOT AVAILABLE
Status:	PRIORITY PERMIT	**Square Feet:**	0.00	**Completed:**	NOT COMPLETED
Valuation:	$0.00	**Assigned To:**	Wilkinson, Matthew	**Approval Expire Date:**	
Description:	PRIORITY PERMIT -- REPAIR	Replace existing septic box			

Parcel: 4753457119.000 Main	**Address:** 195 Third Creek Rd Statesville, NC 28677 Main	**Zone:** R-20(Suburban Residential District)

Property Owner
DAVID HELLMER


Applicant/Authorized Agent
Amy Mistler
206 State Park Rd
Troutman, NC 28166
Mobile: (704) 252-0627

Permit Custom Fields

How is your site plan being submitted	Survey Plat	Septic Application/Permit Type	Repair	Does the site contain any jurisdictional wetlands	No
Non-domestic Sewage Generated	No	Other Public Agency	No	All proposed structure dimensions	existing home on premises
Maximum Number of Bedrooms	3	If other Addition/Structure, please explain		Number of Occupants	6
Foundation Type	Basement with Plumbing	Residential/Business/Other	Residential	Water Supply	Community Well
Desired Septic System Type	Conventional (most common)	If other septic system type, please explain		Pump Make	
# of Nitrification Fields		Model		Serial #	
System Description		Repair System Description		Comments/Conditions	
Permit type(s)	Authorization to Construct, Improvement Permit with Plat	Additional Unique Setbacks Apply	No		

Attachment File Name	Added On	Added By	Attachment Group	Notes
Signature_Amy_Mistler_6/24/2024.jpg	06/24/2024 16:16	Mistler, Amy		Uploaded via CSS
CamScanner 06-24-2024 16.03_1_v1.pdf	06/24/2024 16:27	Mistler, Amy	Available Online	
CamScanner 06-24-2024 16.05_v1.pdf	06/24/2024 16:27	Mistler, Amy	Available Online	

Workflow Step / Action Name	Action Type	Start Date	End Date
Application Completeness Check v.1		06/24/2024 16:27	06/24/2024 16:27
Confirm application complete v.1	Generic Action		06/24/2024 16:27
~~**Zoning Review v.1**~~			06/24/2024 16:28
~~Floodplain Admin Overview v.1~~	Task		06/24/2024 16:28
~~Statesville Zoning Approval v.1~~	Task		06/24/2024 16:28
~~Issue Invoice v.1~~	Generic Action		06/24/2024 16:28
~~Fees Paid v.1~~	Generic Action		06/24/2024 16:28
Fees v.1			
Issue Invoice v.1	Generic Action		
Fees Paid v.1	Generic Action		
~~**Lot Readiness Verification v.1**~~			06/24/2024 16:27

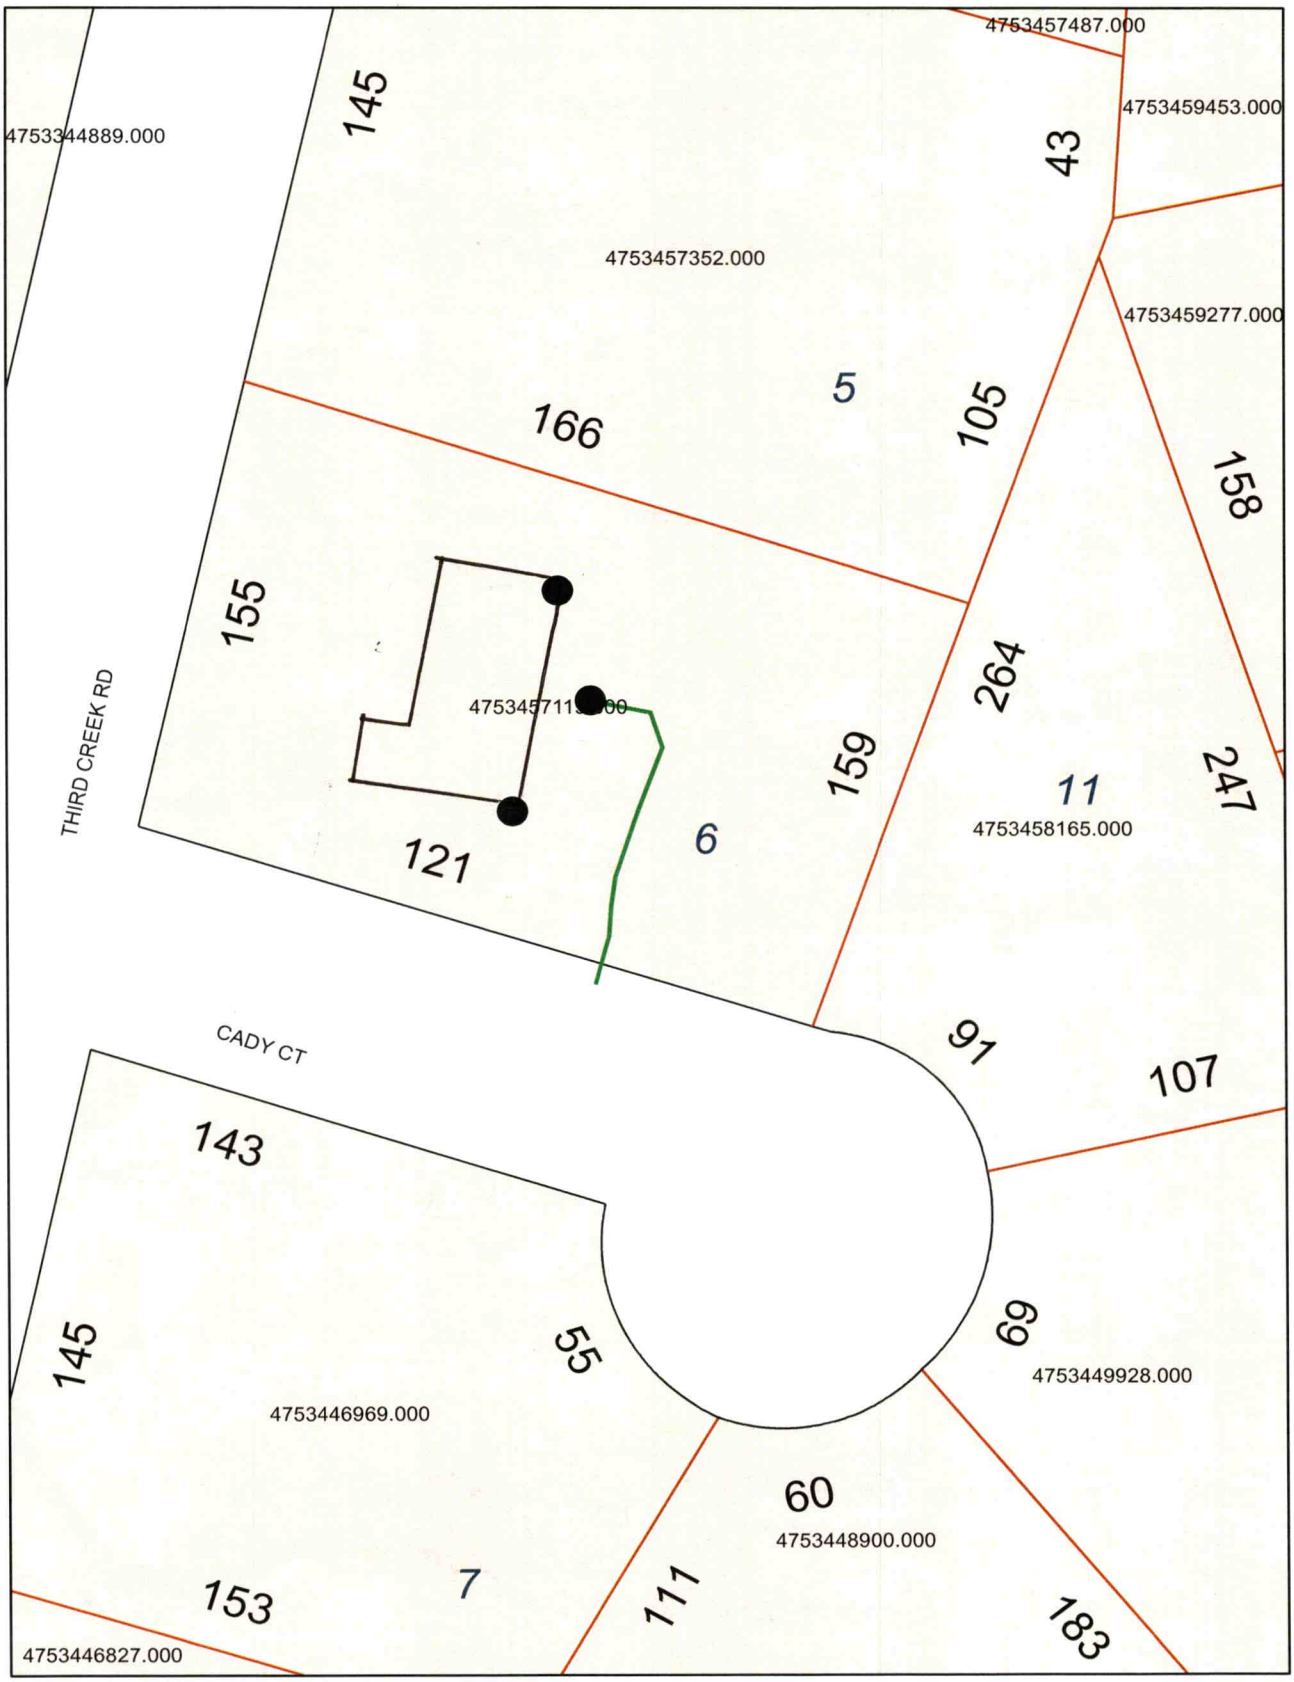
4753457487.000
4753459453.000
4753344889.000
145
43
4753457352.000
4753459277.000
5
166
105
158
155
264
THIRD CREEK RD
159
247
11
4753458165.000
121
6
CADY CT
91
107
143
145
55
69
4753449928.000
4753446969.000
60
4753448900.000
153
7
111
183
4753446827.000