IREDELL COUNTY HEALTH DEPARTMENT

STATESVILLE 704-878-5305 MOORESVILLE 704-664-5281

IMPROVEMENT PERMIT / AUTHORIZATION TO CONSTRUCT / OPERATION PERMIT / EXISTING SYSTEM INSPECTION

PERMIT# REPAIR PIN# 4753-45-8874 DATE 2-22-2008

OWNER OR APPLICANT NENG TOU VUE PHONE: Business 704-239-8739 Home

ADDRESS 631 N. BOUNDARY ST SALISBURY NC 28144

LOCATION US 70 EAST TR THIRD CREEK ROAD, DUPLEX ON LEFT AT #163 & 165

SUBDIVISION SUBURBAN Acres BLOCK / SECTION LOT 1 LOT AREA 1/2 ACRE SITE CLASS. PS DESIGN FLOW 720 L.T.A.R. 0.30 GPD/FT2

Septic Tank: EXISTING Gallons: STB Date

Pump Tank: Gallons: PT Date

Pump Make: Model Serial No.

Nitrification Field: No Fields 1 Square Feet 800 Linear Feet 200

No Lines ONE Trench Width 36" Max Trench Bottom Depth 48" Gravel Depth N/A

☐ New System ☑ Repair ☐ Expansion System Type: I II III IV V VI

System Description:

Repair System Description: SAND-LINED 25% RED CONV

Maintenance Agreement Required: ☐ Yes ☑ No

☑ House/Mod. Home No. Bedrooms 6

☐ Mobile Home No. Persons

☐ Business No. Employees

☐ Other DUPLEX


Water Supply: ☐ Individual ☑ Public ☐ Community

☑ Gravity ☐ Pressure ☐ Slab ☑ Crawl Space ☐ Basement w/plumbing ☐ Basement wo/plumbing


Comments:/Conditions: INSTALL 24" SAND BENEATH CHAMBER, POLYSTYRENE, OR GRAVEL AGGREGATE ② INTERSECT EXISTING DRAINLINE AS SHOWN. ③ LOCATE EXISTING UTILITIES PRIOR TO EXCAVATING

Comments:/Conditions:

INITIAL SITE SKETCH ~ SCALE: 1" = 40'

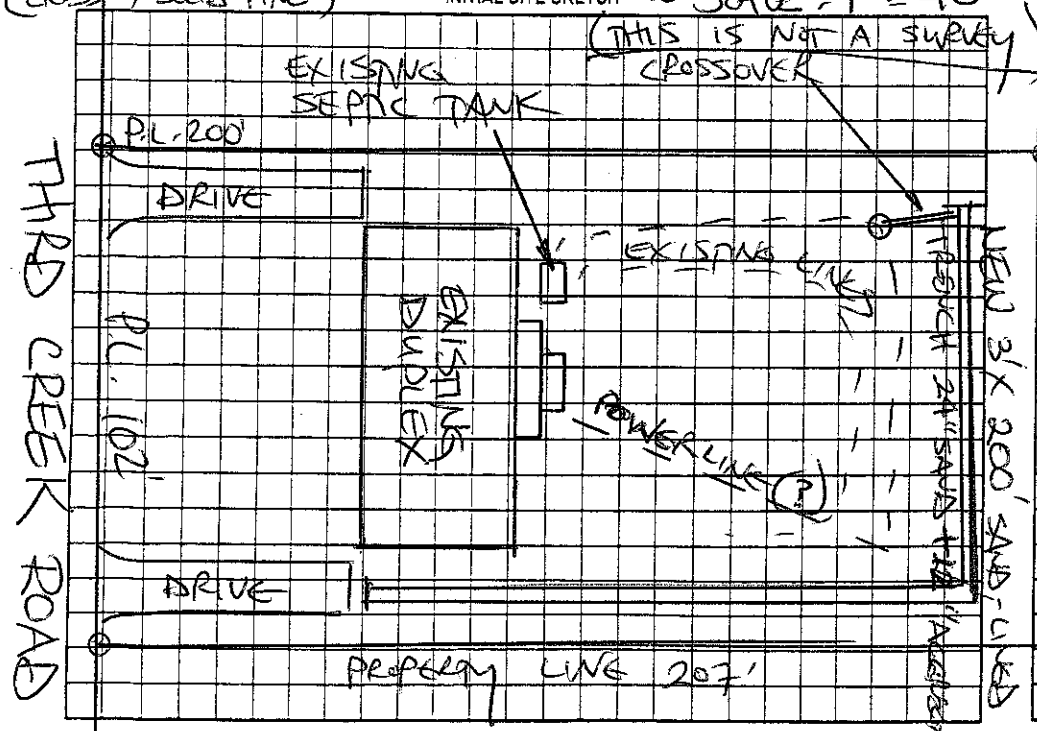

AS BUILT SKETCH

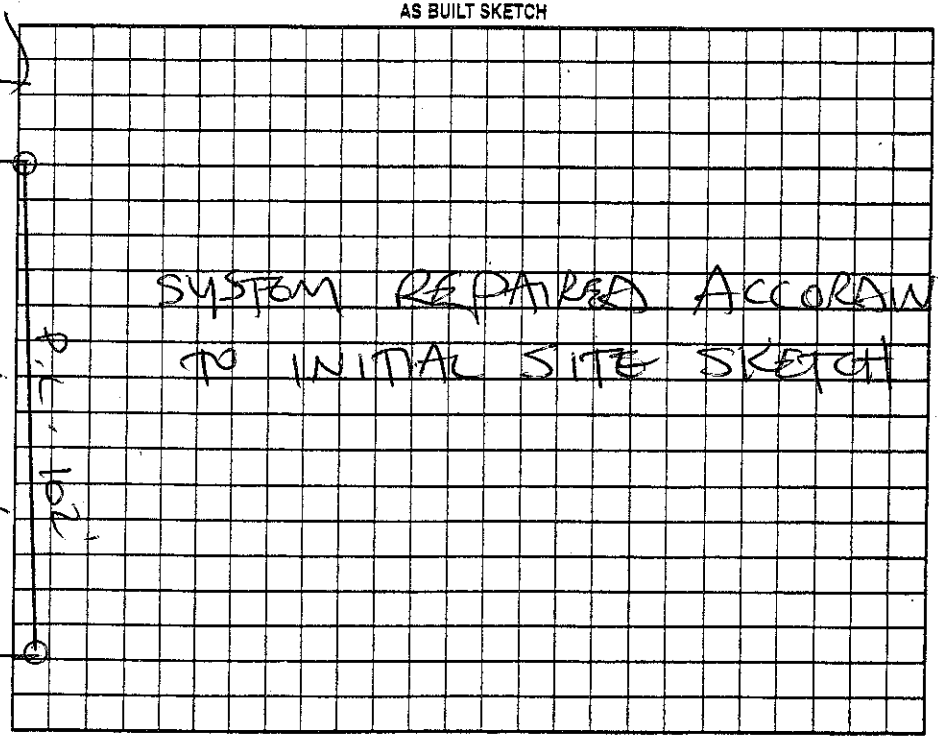

Permit can be suspended or revoked if any false information is supplied toward securing the permit/any unauthorized changes are made to the site/any unauthorized changes are made in the installation of the system. Improvement Permit with plat valid without expiration ☐ Improvement Permit with site plan valid for sixty months ☑ Authorization to Construct is valid for a period equal to that of Improvement Permit – not to exceed sixty months.

Signed: [signature] date 2-22-08 Installed by: ROWAN SEPTIC

Improvement Permit by: STEVE HEDRICK date 2-22-08 Operation Permit by: STEVE HEDRICK date 3-3-08

Authorization to Construct by: STEVE HEDRICK date 2-22-08 Existing System Inspection by: date

HEALTH DEPT. COPY: WHITE OWNER COPY (FINAL): YELLOW OWNER COPY (INITIAL): PINK