IREDELL COUNTY HEALTH DEPARTMENT

Statesville Phone TR 3-7271 — Mooresville Phone NO 3-1271

PERMIT TO INSTALL SEPTIC TANK

Permit NO. _____ Permit Date MARCH 26, 1958

Owner PAUL BARNES Address 142 CYNTHIA ST.

Installed By R. C. OSTWALT Address TROUTMAN


Location of Property DOWN #20 OUT OF STATESVILLE - PASS ST PAULS CH. 1st ROAD RIGHT 1st STREET RIGHT

Tank		Capacity		Length of Lines		Fixtures	
Block	(✓)	800	( )	150'	( )	No. of Baths	(1½)
Precast	( )	900	( )	175'	( )	Dishwasher	( )
		1000	(✓)	200'	( )	Garbage Grdr.	( )
		1100	( )	225'	( )	Auto-Washer	(1)
		1200	( )	250'	( )	Other	
		Other		Other	240'		

NOTIFY HEALTH DEPARTMENT AT LEAST EIGHT HOURS BEFORE TANK IS TO BE INSPECTED.

Final Inspection MARCH 26, 1958 Approved (✓) Disapproved ( )

Remarks LINES 80' EACH - EXCELLENT LAY OUT

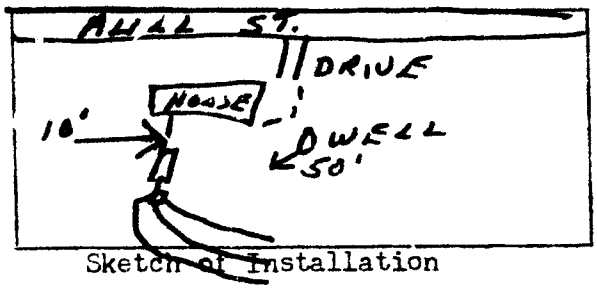

Sketch of Installation

Rafael A Thomas

Sanitarian