IREDELL COUNTY HEALTH DEPARTMENT

Statesville Phone TR 3-7271 Mooresville Phone NO 3-1271

PERMIT TO INSTALL SEPTIC TANK

Permit No. _____ Permit Date 4 - 27 19 72

Owner ROBERT ELDER Address RT. 1 - STATESVILLE

Installed By HARLEE LACKEY Address STONY POINT, N.C.


Location of Property #70 EAST - TURN RIGHT AT HUFFI TEXACO LAST HOUSE ON RT. CHAIN LINK FENCE

Tank	Capacity	Length of Lines	Fixtures
Block ( )	1000	225' ( )	No. of Baths ( )
Precast ( )	1250	300 REPAIR. ( )	Dishwasher ( )
	1500	Other _____	Garbage Grdr. ( )
	Other _____		Other _____

NOTIFY HEALTH DEPARTMENT AT LEAST EIGHT HOURS BEFORE TANK IS TO BE INSPECTED.

Final Inspection 4 - 27 19 72 Approved (✓) Disapproved ( )

Remarks _____

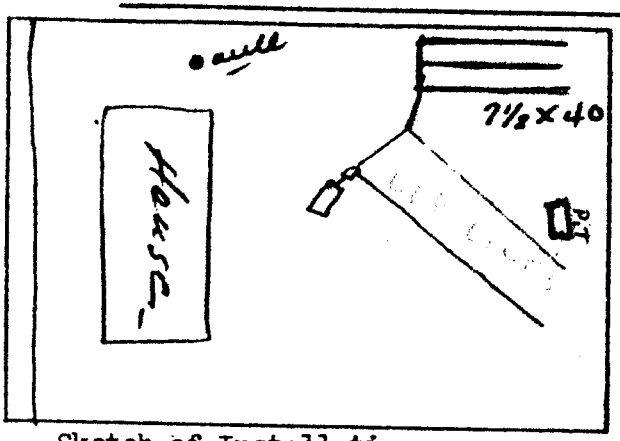

Sketch of Installation

Sanitarian