IREDELL COUNTY HEALTH DEPARTMENT

STATESVILLE 704-878-5305 MOORESVILLE 704-664-5281

IMPROVEMENT PERMIT / AUTHORIZATION TO CONSTRUCT / OPERATION PERMIT / EXISTING SYSTEM INSPECTION

PERMIT# REPAIR PIN# DATE 1-8-99

OWNER OR CONTRACTOR TODD ELLIS / WAYNE POPE PHONE: Business 902-9852 Home

ADDRESS 110 ST. PAUL ROAD STATESVILLE NC 28625

LOCATION US 70 EAST, TR ST. PAUL ROAD, 1ST BRICK HOUSE ON RIGHT AT BOX # 110

SUBDIVISION BLOCK / SECTION LOT LOT AREA LIMITED SITE CLASS. PS DESIGN FLOW 360 L.T.A.R. EXISTING

Septic Tank: EXISTING Gallons; STB Date

Pump Tank: Gallons; PT Date

Pump Make: Model Serial No.

Nitrification Field: No Fields 1 Square Feet EQUIV 900 Linear Feet 300

No Lines FOUR Trench Width 36" Max Trench Bottom Depth 36" ~~Gravel~~ Depth SAND 6'

☐ New System ☑ Repair System Type: I, II, (III), V, V, VI

System Description:

Repair System Description: CHAMBERED GRAVITY

Maintenance Agreement Required: ☐ Yes ☑ No

☑ House/Mod. Home No. Bedrooms 3

☐ Mobile Home No. Bathrooms 1½

☐ Business No. Employees

☐ Other


☐ Slab ☑ Crawl Space ☐ Basement w/plumbing ☐ Basement wo/plumbing

Water Supply: ☑ Individual ☐ Public ☐ Community WELL

Comments:/Conditions: ① THIS PERMIT SERIES AS NOTICE OF VIOLATION ② USE 48 CHAMBERS IN FOUR EQUAL LENGTH LINES (AT REQUEST OF OWNER)

Comments:/Conditions:

INITIAL SITE SKETCH

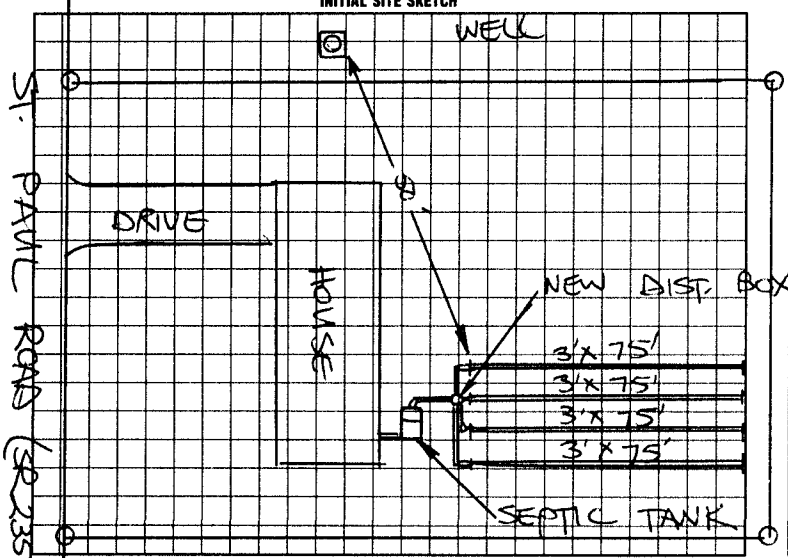

AS BUILT SKETCH

SYSTEM REPAIRED ACCORDING TO INITIAL SITE SKETCH

I understand that this permit can be suspended or revoked if any false information is supplied toward securing the permit/any unauthorized changes are made to the site/any unauthorized changes are made in the installation of the system. Improvement Permit with plat valid without expiration. Improvement Permit with site plan valid for sixty months. Authorization to Construct is valid for a period equal to that of Improvement Permit – not to exceed sixty months.

Signed: + David A. Yountz date 1-8-99 Installed by: DAVID YOUNTZ

Improvement Permit by: STEVE HEDRICK date 1-8-99 Operation Permit by: STEVE HEDRICK date 1-20-99

Authorization to Construct by: STEVE HEDRICK date 1-8-99 Existing System Inspection by: date

HEALTH DEPT. COPY: WHITE INSPECTION COPY (FINAL) GREEN OWNER COPY (FINAL) YELLOW INSPECTION COPY (INITIAL) PINK OWNER COPY (INITIAL) GOLD