CF

# IREDELL COUNTY HEALTH DEPARTMENT

STATESVILLE 704-878-5305 $55.00 Paid MOORESVILLE 704-664-5281

## IMPROVEMENT PERMIT / AUTHORIZATION TO CONSTRUCT / OPERATION PERMIT / EXISTING SYSTEM INSPECTION

PERMIT# 103132 PIN# 4753-52-0076.8 DATE Feb 1, 02

OWNER OR CONTRACTOR M.B. Cline PHONE: Business Home

ADDRESS 141 Cedar Lake Dr. Statesville N.C. 28625

LOCATION 70 East. TR Third Creek Rd TL Morning Dew Dr. on Right

SUBDIVISION Third Creek BLOCK / SECTION LOT 8 LOT AREA .537Ac SITE CLASS PS DESIGN FLOW 360 gpd L.T.A.R. .3

Septic Tank: 1000 Gallons: STB 825 Date 1-31-02
Pump Tank: 1000 Gallons: PT 302 Date 2-13-02
Pump Make: GOULDS Model PE3IM Serial No 503427088
Nitrification Field: No Fields Square Feet 900 Linear Feet 300
No Lines 4 Trench Width 36" Trench Bottom Depth 36" Gravel Depth N/A

✓ New System ☐ Repair System Type: I II III IV V
System Description: QM - INNOVATIVE - 25% Red.
Repair System Description:
Maintenance Agreement Required: ☐ Yes ☐ No

✓ House/Mod Home No. Bedrooms 3
☐ Mobile Home No. Bathrooms 2
☐ Business No. Employees
☐ Other
✓ Slab ☐ Crawl Space ☐ Basement w/plumbing ☐ Basement wo/plumbing


Water Supply: ✓ Individual ☐ Public ☐ Community

Comments/Conditions: Install Laterals at 36" trench bottom depth. Remove old burms/terraces. 36'x28' HOUSE

Comments/Conditions: POLYLOK FILTER MARKER
LINES OK,
⊗ NEED TO MOVE TANKS / ✓ PRESSURE / ELECTRICAL
80' FROM WELL NOW


1"=50'

INITIAL SITE SKETCH

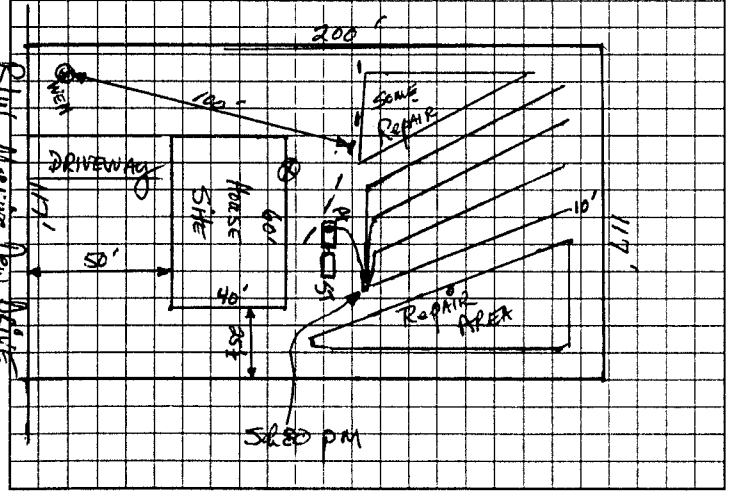


AS BUILT SKETCH

NEIGHBORS WELL NOT DISPLAYED AT TIME OF CHECK. SLAB HOUSE + STUBBED OUT AT ⊗ ON PERMIT. TANKS MUST RESET MARKERS DUG 100' FROM WELL. PRESSURE & INSIDE ELECTRICAL CHECKED. ALL THAT NEEDS TO BE CHECKED IS OUTSIDE ELECTRICAL.
CC 05-22-02
OUTSIDE ✓'D OK 05-23-02 - ALL OK!

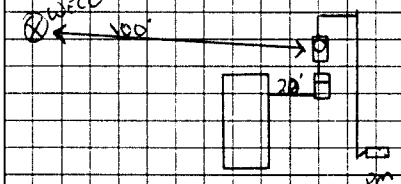


LINES ARE THE SAME SYSTEM INSTALLED AS DRAWN

Permit can be suspended or revoked if any false information is supplied toward securing the permit; any unauthorized changes are made to the site; any unauthorized changes are made in the installation of the system. Improvement Permit with plat valid without expiration. Improvement Permit with site plan valid for sixty months. Authorization to Construct is valid for a period equal to that of Improvement Permit – not to exceed sixty months

Signed: date 2/22/02 Installed by: ROWAN SEPTIC

Improvement Permit by: date Feb 1, 02 Operation Permit by: date 05-23-02

Authorization to Construct by: ES date 02-27-02 Existing System Inspection by: date

HEALTH DEPT COPY WHITE OWNER COPY (FINAL) YELLOW OWNER COPY (INITIAL) PINK