IREDELL COUNTY HEALTH DEPARTMENT

STATESVILLE 704-878-5305 1550 Paid MOORESVILLE 704-664-5281

IMPROVEMENT PERMIT / AUTHORIZATION TO CONSTRUCT / OPERATION PERMIT / EXISTING SYSTEM INSPECTION

PERMIT# 103134 PIN# 4753-52-0076.10 DATE Feb 1, 02

OWNER OR CONTRACTOR M.B. CLINE PHONE Business Home

ADDRESS 141 Cedar Lake Dr. Statesville N.C. 28625

LOCATION TO East TR Third Creek Rd. TR Morning Dew Dr. on Right

SUBDIVISION Third Creek BLOCK / SECTION LOT 10 LOT AREA .537Ac SITE CLASS PS DESIGN FLOW 360gpd L.T.A.R. .3

Septic Tank: 1000 Gallons: STB 825 Date 01-16-01
Pump Tank: 1000 Gallons: PT 302 Date 01-23-02
Pump Make: GOULDS Model PE 31M Serial No 30 3427272
Nitrification Field: No Fields 1 Square Feet 900 Linear Feet 300
No Lines 4 Trench Width 36" Trench Bottom Depth 36" Gravel Depth NA

☑ New System ☐ Repair System Type: I II III IV V VI
System Description: PM-INNOVATIVE -25% Red.
Repair System Description: LP PUMPS
Maintenance Agreement Required: ☐ Yes ☑ No Initially

☑ House/Mod Home No. Bedrooms 3
☐ Mobile Home No. Bathrooms 2
☐ Business No. Employees
☐ Other


☑ Slab ☐ Crawl Space ☐ Basement w/plumbing ☐ Basement wo/plumbing

Water Supply: ☑ Individual ☐ Public ☐ Community

Comments/Conditions: Install laterals at 36" trench bottom depth. Well site Lot 11 46126' NO GARAGE

Comments/Conditions: POLYLOK FITTER & MARKER

INITIAL SITE SKETCH 1"=50'

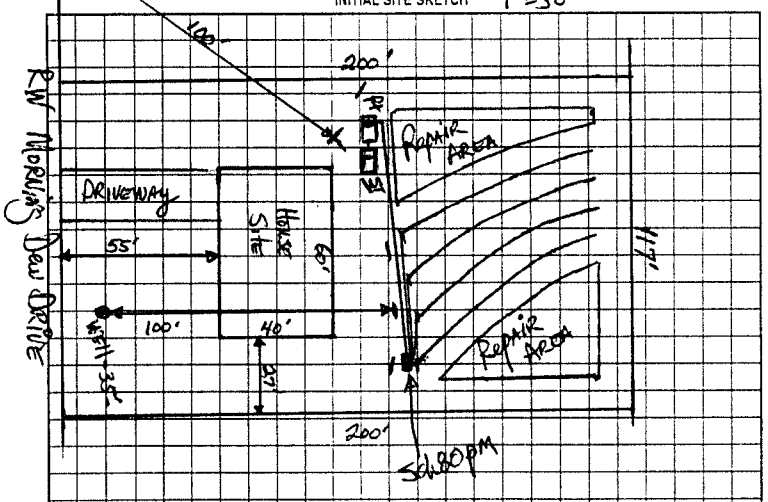

AS BUILT SKETCH

CHECKED LEVELS & SET PRESSURE. NEEDS ELECTRICIAL & PUMP INFO. KEVIN IS GOING TO GET IT

NEEDS INSIDE ALARM & ELECTRICAL W.O. (C)

Permit can be suspended or revoked if any false information is supplied toward securing the permit; any unauthorized changes are made to the site; any unauthorized changes are made in the installation of the system. Improvement Permit with plat valid without expiration. Improvement Permit with site plan valid for sixty months. Authorization to Construct is valid for a period equal to that of Improvement Permit - not to exceed sixty months

Signed: date 2/22/02 Installed by FOWAN SEPTIC

Improvement Permit by: date 2-1-02 Operation Permit by: date 07/18/02

Authorization to Construct by: date 02-27-02 Existing System Inspection by: date

HEALTH DEPT COPY WHITE OWNER COPY (FINAL) YELLOW OWNER COPY (INITIAL) PINK