IREDELL COUNTY HEALTH DEPARTMENT

STATESVILLE 704-878-5305 (01) MOORESVILLE 704-664-5281

IMPROVEMENT PERMIT / AUTHORIZATION TO CONSTRUCT / OPERATION PERMIT / EXISTING SYSTEM INSPECTION

PERMIT# 18342/21251 PIN# 4753-52-0076.14 51-4921 DATE Sept 25, 02

OWNER OR CONTRACTOR MB Cline // Pilot Homes PHONE: Business 202-4964 Home

ADDRESS 141 Cedar Lake Dr. Statesville // 450 Auction Dr. Salisbury 28144

LOCATION 70 East TR Third Creek TL Morning Dew Dr. on left NEAR/AT END

SUBDIVISION Third Creek BLOCK / SECTION 2 LOT 14 Revised LOT AREA 2.223 ac SITE CLASS. PS DESIGN FLOW 360 gpd L.T.A.R. .03 System AREA

Septic Tank: 1000 Gallons; STB 825 Date 7-20-09
Pump Tank: 1000 Gallons; PT 302 Date 7-17-09
Pump Make: GOULDS Model PE4IM Serial No. C0360253
Nitrification Field: No Fields 1 Square Feet 900 Linear Feet 300
No Lines 3@100' Trench Width 36" Max Trench Bottom Depth 36" Gravel Depth NA

☑ New System ☐ Repair System Type: I, II, III, IV, V, VI
System Description: PM 25% Reduction
Repair System Description: LPPBPS
Maintenance Agreement Required: ☐ Yes ☑ No initially

☑ House/Mod. Home No. Bedrooms 3
☐ Mobile Home No. Bathrooms 2
☐ Business No. Employees
☐ Other


Water Supply: ☑ Individual ☐ Public ☐ Community

☑ Slab ☐ Crawl Space ☐ Basement w/plumbing ☐ Basement wo/plumbing


Comments/Conditions: 250'

Comments/Conditions: 120.61 ① SEPTIC TANK WITH MARKER INSTALLED USING "POLYLOK" FILTER ② LINES CHECKED & PRESSURE TESTED O.K 9-16-09

INITIAL SITE SKETCH

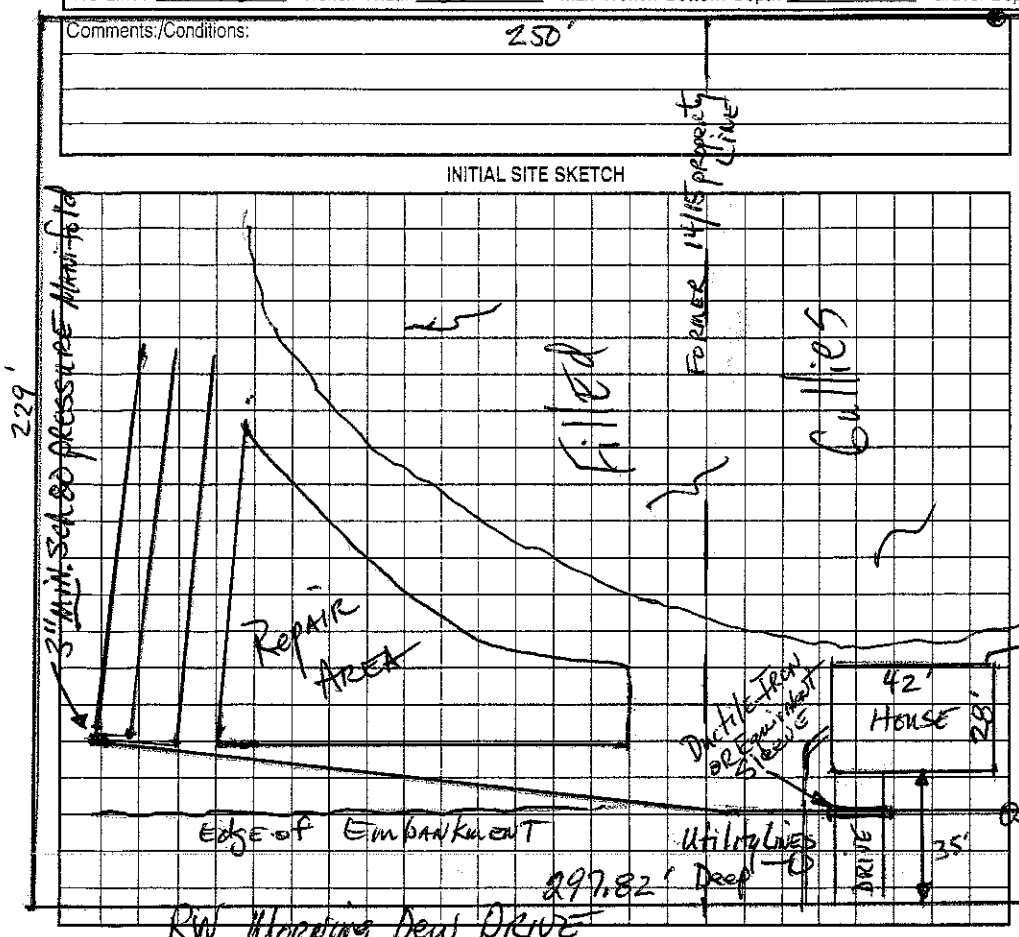

AS BUILT SKETCH 1"=50'

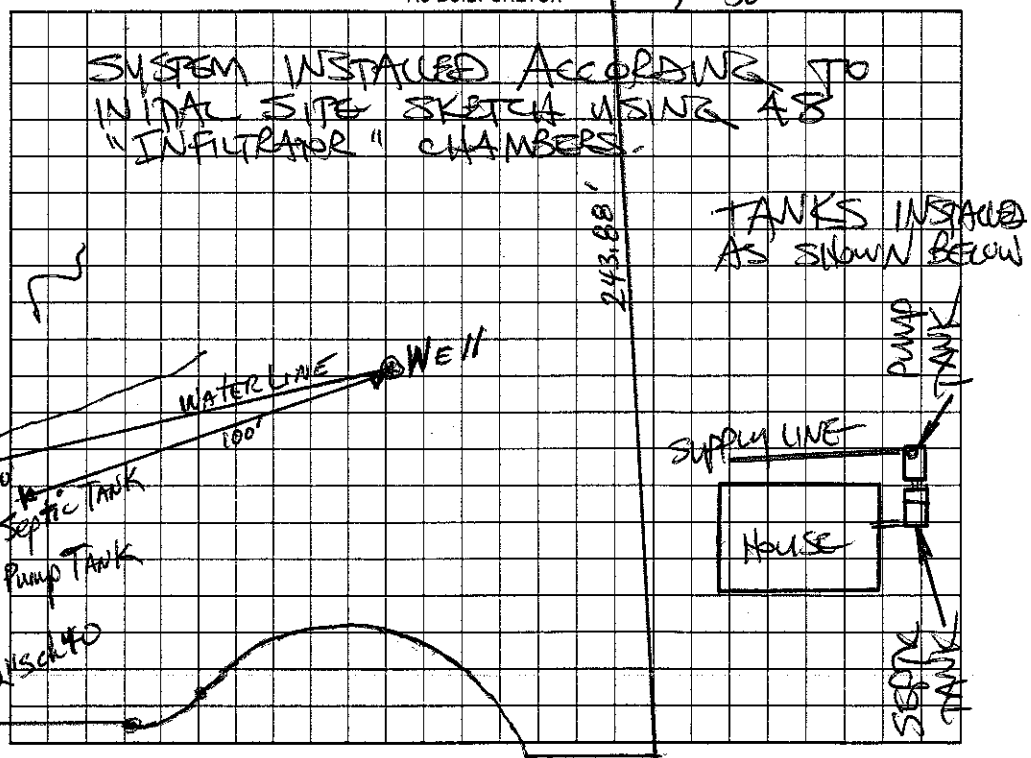

Permit can be suspended or revoked if any false information is supplied toward securing the permit/any unauthorized changes are made to the site/any unauthorized changes are made in the installation of the system. Improvement Permit with plat valid without expiration. Improvement Permit with site plan valid for sixty months. Authorization to Construct is valid for a period equal to that of Improvement Permit – not to exceed sixty months.

Signed: _____ date 9/27/02 Installed by: Rowan Septic

Improvement Permit by: Mark R. Hyman, RS date 9-25-02 Operation Permit by: Steve Hedrick date 10-20-09

Authorization to Construct by: Mark R. Hyman, RS date 9-27-02 Existing System Inspection by: _____ date _____

HEALTH DEPT. COPY: WHITE OWNER COPY (FINAL): YELLOW OWNER COPY (INITIAL): PINK