IREDELL COUNTY HEALTH DEPARTMENT

STATESVILLE 704-878-5305 155.00 Paid VCE MOORESVILLE 704-664-5281

IMPROVEMENT PERMIT / AUTHORIZATION TO CONSTRUCT / OPERATION PERMIT / EXISTING SYSTEM INSPECTION

PERMIT# 103137 PIN# 4753-52-0076.12 DATE Feb 5, 02

OWNER OR CONTRACTOR M.B. Cline PHONE Business Home

ADDRESS 141 Cedar Lake Dr. Statesville N.C. 28625

LOCATION To East TR Third Creek TL Morning Dew Dr. on Right at end

SUBDIVISION Third Creek BLOCK / SECTION LOT 12 LOT AREA .476 Ac SITE CLASS PS DESIGN FLOW 360 gpd L.T.A.R. .03

Septic Tank: 1000 Gallons: STB 825 Date 1-4-02
Pump Tank: 1000 Gallons: PT 302 Date 2-6-02
Pump Make: Gould Model PE3M Serial No S0342 7272
Nitrification Field: No. Fields 1 Square Feet 400/600 Linear Feet 200
No. Lines 4 @ 50' Trench Width 24" Min Bot Max Trench Bottom Depth 36" Gravel Depth N/A

☑ New System ☐ Repair System Type: I II III IV V VI
System Description: PM- PPBPS
Repair System Description: Same
Maintenance Agreement Required: ☐ Yes ☑ No

☑ House/Mod. Home No. Bedrooms 3
☐ Mobile Home No. Bathrooms 2
☐ Business No. Employees
☐ Other

☑ Slab ☐ Crawl Space ☐ Basement w/plumbing ☐ Basement wo/plumbing


Water Supply: ☑ Individual ☐ Public ☐ Community

Comments/Conditions: OR 36" max 9'OC


50'x32' HOUSE FLIP FLOP HOUSE PLANS

Comments/Conditions: PM/Lok Filter Installed, MH ST Okay, PT Riser Okay, Pressure check Okay, lines Okay V'd Everything LEFT ON 6-26-02 LL

1"=50' INITIAL SITE SKETCH

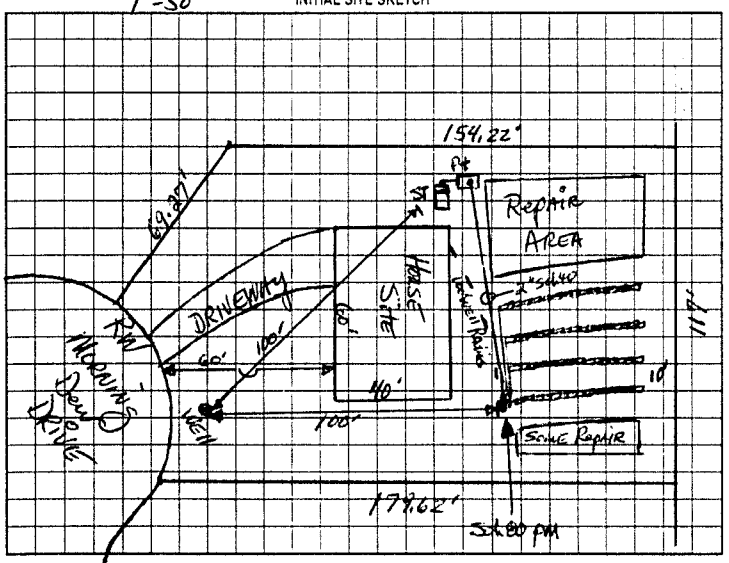

AS BUILT SKETCH

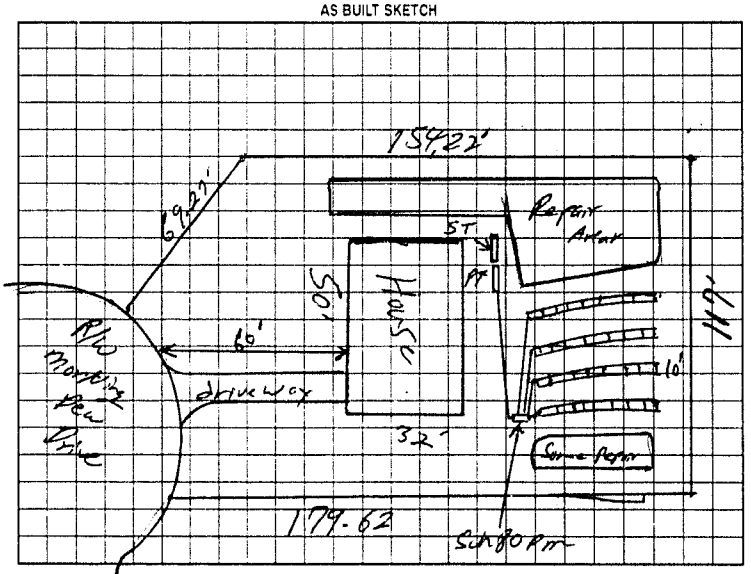

Permit can be suspended or revoked if any false information is supplied toward securing the permit, any unauthorized changes are made to the site, any unauthorized changes are made in the installation of the system. Improvement Permit with plat valid without expiration. Improvement Permit with site plan valid for sixty months. Authorization to Construct is valid for a period equal to that of Improvement Permit – not to exceed sixty months.

Signed: date 2/22/02 installed by Kavan Septic

Improvement Permit by: date 2-5-02 Operation Permit by: date 06-26-02

Authorization to Construct by: date 02-27-02 Existing System Inspection by: date

HEALTH DEPT. COPY WHITE OWNER COPY (FINAL) YELLOW OWNER COPY (INITIAL) PINK