IREDELL COUNTY HEALTH DEPARTMENT

STATESVILLE 704-878-5305 MOORESVILLE 704-664-5281

IMPROVEMENT PERMIT / AUTHORIZATION TO CONSTRUCT / OPERATION PERMIT / EXISTING SYSTEM INSPECTION

PERMIT# 103141 PIN# 4753 51 6675 DATE August 31, 2006

OWNER OR APPLICANT Spear Bldrs Inc. PHONE: Business 704 202-4964 Home

ADDRESS 172 Allendale Circle Troutman N.C. 28166

LOCATION from Statesville 70 East TR Third Creek Rd. TL Morning Dew Dr. at end

SUBDIVISION Third Creek BLOCK / SECTION II LOT 13 LOT AREA 1.178Ac SITE CLASS. PS DESIGN FLOW 360gpd L.T.A.R. .03

Septic Tank: 1000 Gallons; STB 823 Date 10-2-06

Pump Tank: 1000 Gallons; PT 302 Date 9-17-06

Pump Make: Zoeller Model N153 Serial No.

Nitrification Field: No Fields 1 Square Feet 900 Linear Feet 300

No Lines 3@100' Trench Width 36" Max Trench Bottom Depth 36" Gravel Depth NA ☐ Gravity ☒ Pressure ☐ Slab ☒ Crawl Space ☐ Basement w/plumbing ☐ Basement wo/plumbing

☒ New System ☐ Repair ☐ Expansion System Type: I II III IV V VI

System Description: PM 25% Reduction

Repair System Description: PM/LP 25-50% Reduction

Maintenance Agreement Required: ☐ Yes ☒ No Initially

☒ House/Mod. Home ☐ Mobile Home ☐ Business ☐ Other


No. Bedrooms 3 No. Persons No. Employees

Water Supply: ☒ Individual ☐ Public ☐ Community

Comments/Conditions: Pumpspecs 22gpm @ approx 284 TDH

Comments/Conditions: Blue Filter

INITIAL SITE SKETCH

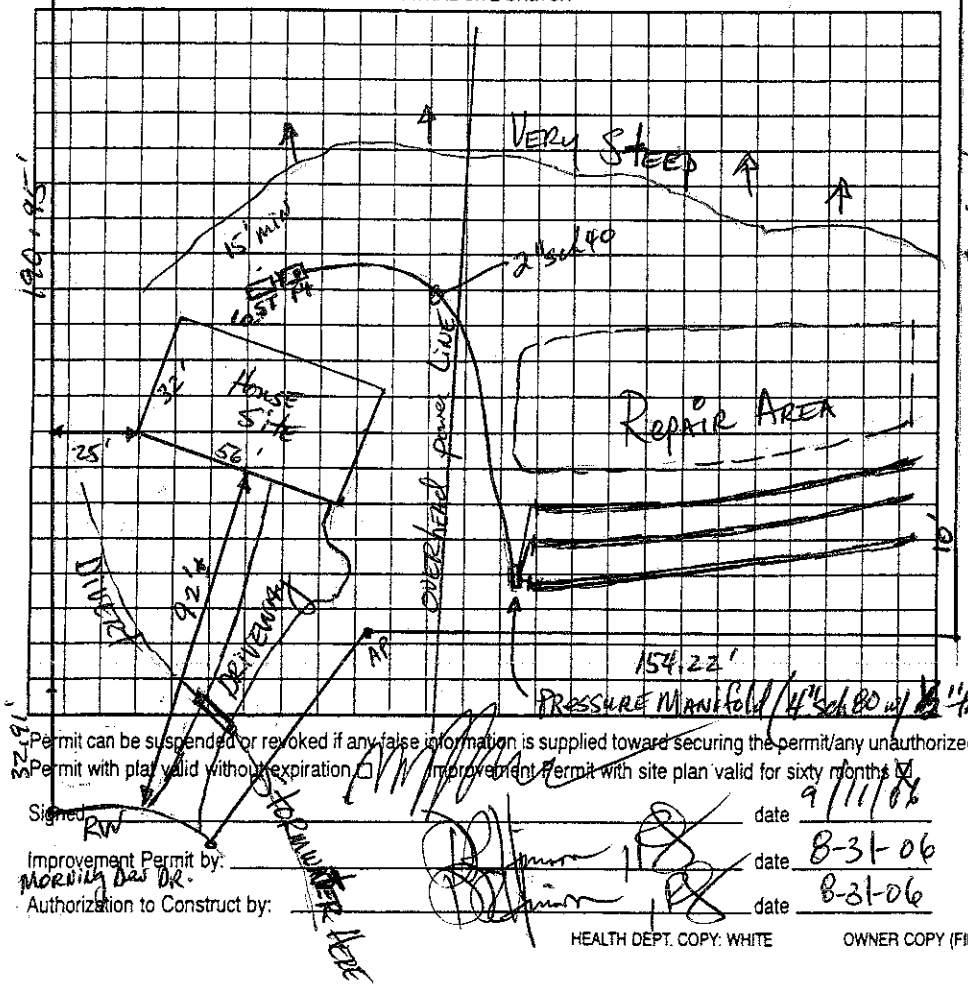

AS BUILT SKETCH

Permit can be suspended or revoked if any false information is supplied toward securing the permit/any unauthorized changes are made to the site/any unauthorized changes are made in the installation of the system. Improvement Permit with plat valid without expiration ☐ Improvement Permit with site plan valid for sixty months ☒ Authorization to Construct is valid for a period equal to that of Improvement Permit – not to exceed sixty months.

Signed RW date 9/11/06

Improvement Permit by: date 8-31-06

Authorization to Construct by: date 8-31-06

Installed by: Rowan Septic

Operation Permit by: date 12-13-06

Existing System Inspection by: date

HEALTH DEPT. COPY: WHITE OWNER COPY (FINAL): YELLOW OWNER COPY (INITIAL): PINK