IREDELL COUNTY HEALTH DEPARTMENT

Statesville Phone TR 3-7271 Mooresville Phone NO 3-1271

PERMIT TO INSTALL SEPTIC TANK

Permit No. 139 Permit Date 7-24-1972

Owner Kenneth Wooten Address Mooresville

Installed By Orbison Address Mooresville


Location of Property Rt 1116 Homestead Estates 7th House on left. Lot 9

Tank		Capacity		Length of Lines		Fixtures	
Block	( )	1000	(✓)	225'	( )	No. of Baths	(3)
Precast	(✓)	1250	( )	250'	( )	Dishwasher	(~~No~~)
		1500	( )	Other 300		Garbage Grdr.	(~~No~~)
		Other				Other	

NOTIFY HEALTH DEPARTMENT AT LEAST EIGHT HOURS BEFORE TANK IS TO BE INSPECTED.

Final Inspection 7-24-1972 Approved (✓) Disapproved ( )

Remarks Central Water House

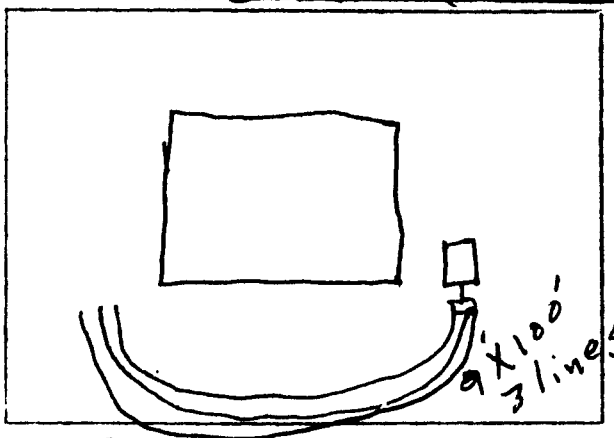

Sketch of Installation

D. C. Moore

Sanitarian