IREDELL COUNTY HEALTH DEPARTMENT

STATESVILLE 704-878-5305 MOORESVILLE 704-664-5281

IMPROVEMENT PERMIT / AUTHORIZATION TO CONSTRUCT / OPERATION PERMIT / EXISTING SYSTEM INSPECTION

PERMIT# REPAIR PIN# 4753-51-9485 DATE 7-23-03

OWNER OR CONTRACTOR JERRY MICHAEL HORTON PHONE: Business 704-872-2103(2016) Home 704-871-9485

ADDRESS 164 HOMESTEAD ESTATES DRIVE STATESVILLE NC 28677

LOCATION US 70 EAST, TR SHILOH ROAD, TR HOMESTEAD ESTATES DRIVE, AT END ON RIGHT AT 164

SUBDIVISION HOMESTEAD EST. BLOCK / SECTION ____ LOT 8,9 LOT AREA 1.6 ACRE SITE CLASS. PS DESIGN FLOW 480 L.T.A.R. EXISTING

Septic Tank: EXISTING Gallons: STB ____ Date ____

Pump Tank: ____ Gallons: PT ____ Date ____

Pump Make: ____ Model ____ Serial No. ____

Nitrification Field: No Fields 1 Square Feet 480 Linear Feet 160

No Lines TWO Trench Width 36" Max Trench Bottom Depth 36"

☐ New System ☑ Repair System Type: I (II) III, IV, V, VI

System Description: ____

Repair System Description: CONVENTIONAL, GRAVITY

Maintenance Agreement Required: ☐ Yes ☑ No

Gravel Depth 24"

☑ House/Mod. Home No. Bedrooms 4

☐ Mobile Home No. Bathrooms 2

☐ Business No. Employees ____

☐ Other ____


☐ Slab ☐ Crawl Space ☑ Basement w/plumbing ☐ Basement wo/plumbing

Water Supply: ☐ Individual ☑ Public ☐ Community

Comments:/Conditions: ① INSTALL NEW DISTRIBUTION BOX AT SEPTIC TANK AS SHOWN FEEDING OLD BED SYSTEM FIRST ② INSTALL NEW DROP BOX AS SHOWN FEEDING TWO NEW 3' X 80' LINES ON CONTOUR USING 24" STONE

Comments:/Conditions:

INITIAL SITE SKETCH

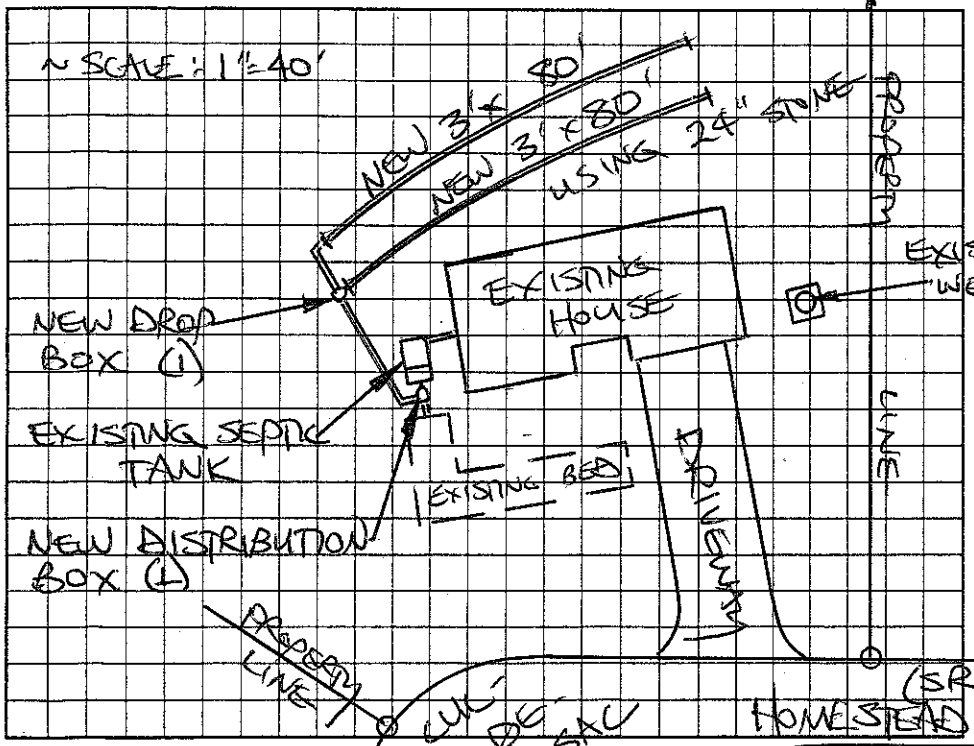

AS BUILT SKETCH

SYSTEM REPAIRED ACCORDING TO INITAL SITE SKETCH

Permit can be suspended or revoked if any false information is supplied toward securing the permit/any unauthorized changes are made to the site/any unauthorized changes are made in the installation of the system. Improvement Permit with plat valid without expiration. Improvement Permit with site plan valid for sixty months. Authorization to Construct is valid for a period equal to that of Improvement Permit – not to exceed sixty months.

Signed: X Jerry M Horton date 7-23-03

Improvement Permit by: STEVE HEDRICK date 7-23-03

Authorization to Construct by: STEVE HEDRICK date 7-23-03

Installed by: JAMES HUDLER

Operation Permit by: STEVE HEDRICK date 7-25-03

Existing System Inspection by: ____ date ____

HEALTH DEPT. COPY: WHITE OWNER COPY (FINAL): YELLOW OWNER COPY (INITIAL): PINK