IREDELL COUNTY HEALTH DEPARTMENT

STATESVILLE 704-878-5305 CI MOORESVILLE 704-664-5281

IMPROVEMENT PERMIT / AUTHORIZATION TO CONSTRUCT / OPERATION PERMIT / EXISTING SYSTEM INSPECTION

PERMIT# 107185 PIN# 4753-53-0813 DATE 08/13/02

OWNER OR CONTRACTOR HOWARD BRYAN, BRYAN CONSTRUCTION PHONE: Business 704-871-7950 Home

ADDRESS PO BOX 1654 STATESVILLE, NC 28677

LOCATION HWY 70 E, (TR) THIRD CREEK RD, 1/4 MILE ON LEFT TAKE SIGNAL DRIVE, (R) 1/2 MILE CRAFT LANE, LOT ON LEFT

SUBDIVISION SUBURBAN ACRES BLOCK / SECTION — LOT — LOT AREA 1.927 ACRES SITE CLASS PS DESIGN FLOW 360 GPD L.T.A.R. 0.30

Septic Tank: 1,000 Gallons; STB 1012 Date 9-16-03

Pump Tank: Gallons; PT Date

Pump Make: Model Serial No.

Nitrification Field: No Fields 1 Square Feet Linear Feet 200

No Lines 4x50' Trench Width 36" 24" Max Trench Bottom Depth 36" Gravel Depth N/A

[X] New System [ ] Repair System Type: I, II, (III), IV, V, VI

System Description: 50% Reduction, Gravity

Repair System Description: 50% Reduction, LP

Maintenance Agreement Required: [ ] Yes [X] No

[ ] House/Mod. Home [X] Mobile Home [ ] Business [ ] Other

No. Bedrooms 3 No. Bathrooms 2 No. Employees


[ ] Slab [X] Crawl Space [ ] Basement w/plumbing [ ] Basement wo/plumbing

Water Supply: [ ] Individual [X] Public [ ] Community


Comments:/Conditions: ① SYSTEM "MUST" GO IN PROPOSED LOCATION DUE TO FILL MATERIAL. ② INSTALL SYSTEM USING 55 PANELS + DISTRIBUTION BOX using SPEED LEVELERS ③ MAINTAIN ALL SET BACKS

Comments:/Conditions: -Tuff-Tite filter + ST Marker

INITIAL SITE SKETCH

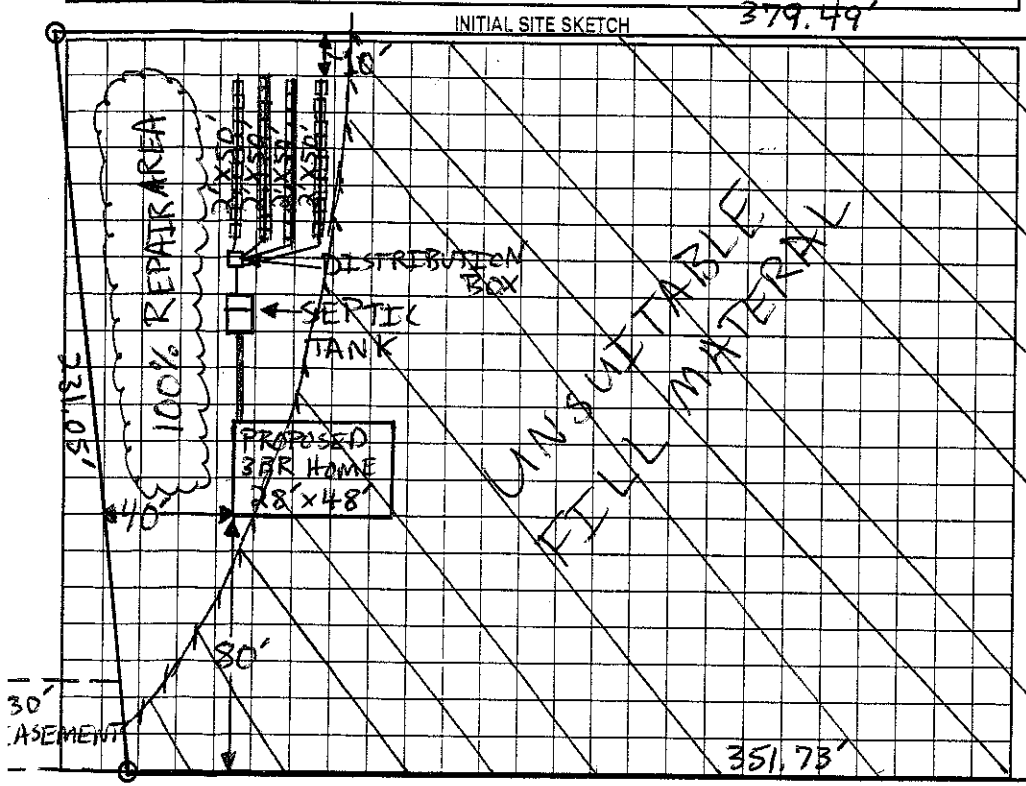

AS BUILT SKETCH

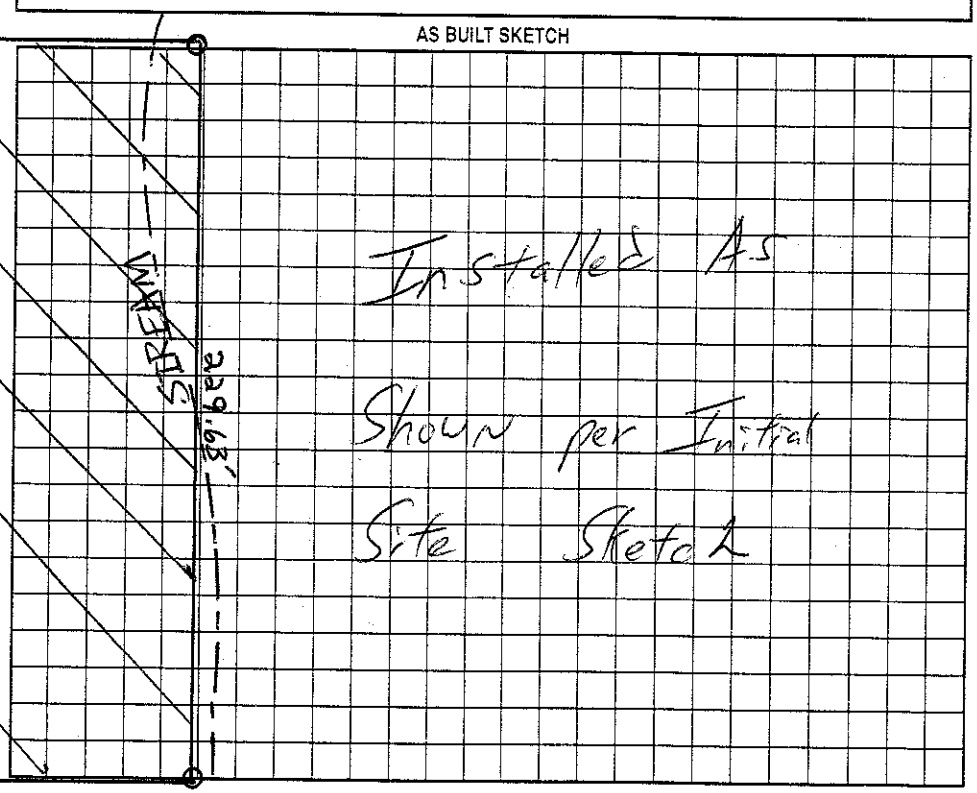

Permit can be suspended or revoked if any false information is supplied toward securing the permit/any unauthorized changes are made to the site/any unauthorized changes are made in the installation of the system. Improvement Permit with plat valid without expiration. Improvement Permit with site plan valid for sixty months. Authorization to Construct is valid for a period equal to that of Improvement Permit – not to exceed sixty months.

Signed: Howard J. Bryan date 8-29-02 Installed by: Craig Thompson

Improvement Permit by: Patsy Mitchell date 08/13/02 Operation Permit by: William O. Johnson date 3/29/04

Authorization to Construct by: Patsy Mitchell date 08/13/02 Existing System Inspection by: date

HEALTH DEPT. COPY: WHITE OWNER COPY (FINAL): YELLOW OWNER COPY (INITIAL): PINK