IREDELL COUNTY HEALTH DEPARTMENT

STATESVILLE 704-878-5305 MOORESVILLE 704-664-5281

IMPROVEMENT PERMIT / AUTHORIZATION TO CONSTRUCT / OPERATION PERMIT / EXISTING SYSTEM INSPECTION

PERMIT# 137556 PIN# 4753533708 DATE 8-28-06

OWNER OR APPLICANT Juan & Maria Nunez PHONE: Business Home 704-682-1412

ADDRESS 164 Oak Grove Rd Statesville NC 28677

LOCATION 77S Exit 146 (L) 3rd Creek (L) Wilmer (R) Seymour 1st on Right before Dwyers

SUBDIVISION Suburban Acres BLOCK / SECTION LOT 7 LOT AREA .472 SITE CLASS. RS DESIGN FLOW 360 L.T.A.R. .25

Septic Tank: Exist Gallons; STB Date

Pump Tank: Gallons; PT Date

Pump Make: Model Serial No.

Nitrification Field: No Fields 1 Square Feet 480 Linear Feet 130

No Lines 3 Trench Width 36" Max Trench Bottom Depth 36" Gravel Depth ☐ Gravity ☐ Pressure

☐ New System ☐ Repair ☑ Expansion System Type: I II III IV V VI

System Description: 25% Expansion

Repair System Description: Low Pressure

Maintenance Agreement Required: ☐ Yes ☐ No

☐ House/Mod. Home No. Bedrooms 3

☐ Mobile Home No. Persons

☐ Business No. Employees

☐ Other


Water Supply: ☐ Individual ☑ Public ☐ Community

☐ Slab ☐ Crawl Space ☐ Basement w/plumbing ☐ Basement wo/plumbing

Comments:/Conditions:

Use ~~Repair~~ Existing tank (unless damaged)
Use distribution box (3) Speed levels
(1) going to exist 105' lead. (2) to existing 90'

INITIAL SITE SKETCH

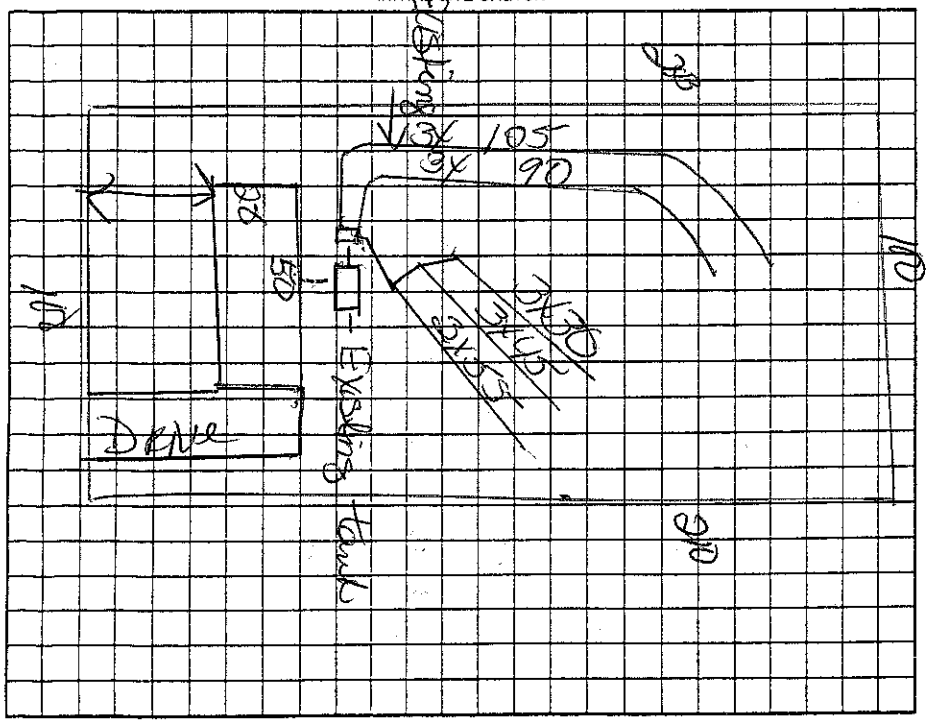

Comments:/Conditions:

(3rd) to NEW 25% 1st line
use end caps as
distribution on NEW 25% Line
90'

AS BUILT SKETCH

Set speed levels to feed
New system 1st
* Scarred side walls
of trenches (due to rain)

Permit can be suspended or revoked if any false information is supplied toward securing the permit/any unauthorized changes are made to the site/any unauthorized changes are made in the installation of the system. Improvement Permit with plat valid without expiration ☐ Improvement Permit with site plan valid for sixty months ☐ Authorization to Construct is valid for a period equal to that of Improvement Permit – not to exceed sixty months.

Signed: Juan Nunez date

Improvement Permit by: Kelli Cook date 8-28-06

Authorization to Construct by: Kelly Cook date 8-28-06

Installed by: Holt Green Grading

Operation Permit by: Kelly Cook date 9-17-06

Existing System Inspection by: date

HEALTH DEPT. COPY: WHITE OWNER COPY (FINAL): YELLOW OWNER COPY (INITIAL): PINK