IREDELL COUNTY HEALTH DEPARTMENT

STATESVILLE 704-878-5305 MOORESVILLE 704-664-5281

IMPROVEMENT PERMIT / CERTIFICATE OF COMPLETION / OPERATION PERMIT / EXISTING SYSTEM INSPECTION

PROPERTY DESCRIPTION NO. _____ DATE 12-6-93 TAX MAP NO. _____ Watershed: ☑ Yes ☐ No

OWNER OR CONTRACTOR Calvin Clark PHONE: Business _____ Home 878 0048

ADDRESS Rt 15 Box 116 Statesville, N.C

LOCATION 70 E TR Third Creek Tl pecan TR Sigmon TR oakGrove last House on left

SUBDIVISION Suburban Acres BLOCK / SECTION _____ LOT 17 LOT AREA 1/2 acres SITE CLASS. _____ DESIGN FLOW _____ L.T.A.R. .3

Septic Tank: EX Gallons; STB _____ Date _____

Pump Tank: _____ Gallons; PT _____ Date _____

Pump Make: _____ Model _____ Serial No. _____

Nitrification Field: No Fields 1 Square Feet 450 Linear Feet 150

No Lines 2 Trench Width 60 Max Trench ~~Bottom Depth~~ 36 ± Gravel Depth 18"

☐ New System ☑ Repair System Type: I, II, III, IV, V, VI

System Description: _____

Repair System Description: _____

Maintenance Agreement Required: ☐ Yes ☐ No

☐ ~~House/Mod. Home~~ No. Bedrooms 3

☐ Mobile Home No. Bathrooms 2

☐ Business No. Employees _____

☐ Other _____

☐ Slab ☑ Crawl Space ☐ Basement w/plumbing ☐ Basement wo/plumbing

Water Supply:
☐ Individual
☑ ~~Community~~
☐ Public


Comments:

Divert surface water around system


Smooth area over EX lines + new lines + sow back with grass

Comments:

INITIAL SITE SKETCH

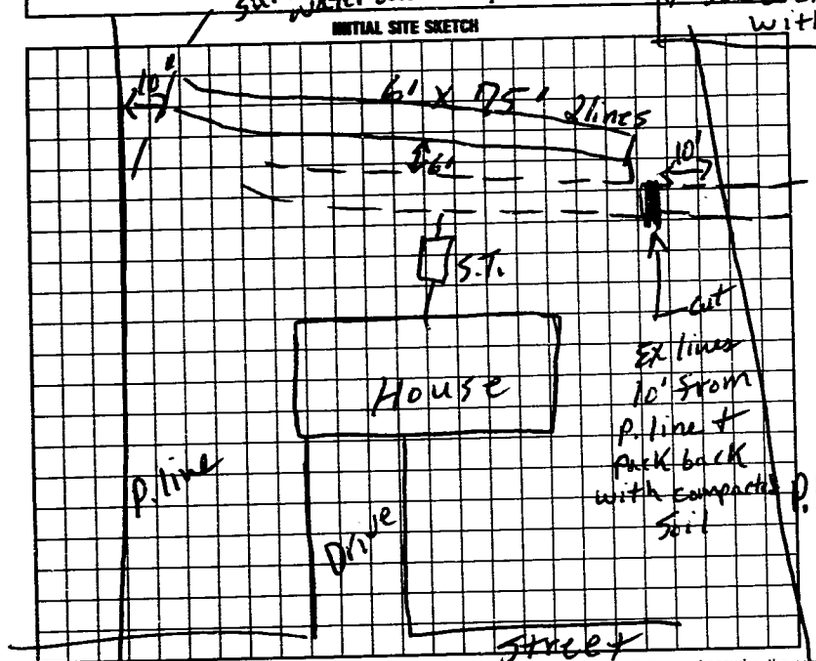

AS BUILT SKETCH

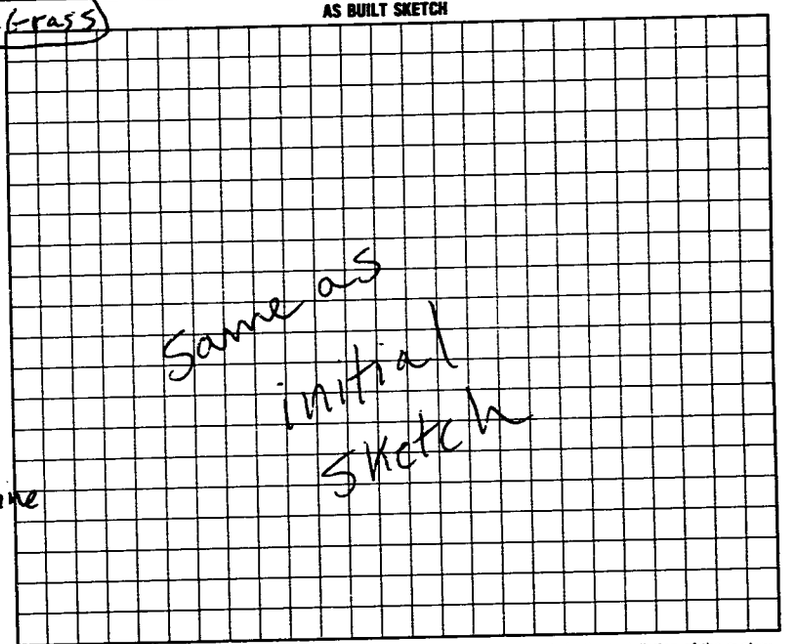

I understand that this permit can be suspended or revoked if any false information is supplied toward securing the permit/any unauthorized changes are made to the site/any unauthorized changes are made in the installation of the system. Improvement Permit is valid for 60 months from date of issuance.

Signed: xCalvin R Clark

Improvement Permit by: E.C. Moore date 12-6-93

Existing System Inspection by: _____ date _____

Installed by: Donald Fackler

Certificate of Completion by: E.C. Moore date 12-9-93

Operation Permit by: _____ date _____

HEALTH DEPT. COPY: WHITE INSPECTION COPY (FINAL): GREEN OWNER COPY (FINAL): YELLOW INSPECTION COPY (INITIAL): PINK OWNER COPY (INITIAL): GOLD