IREDELL COUNTY HEALTH DEPARTMENT

STATESVILLE 704-878-5305 MOORESVILLE 704-664-5281

IMPROVEMENT PERMIT / AUTHORIZATION TO CONSTRUCT / OPERATION PERMIT / EXISTING SYSTEM INSPECTION

PERMIT# REPAIR PIN# 4753-54-1520 DATE 5-24-05

OWNER OR CONTRACTOR DEBRA HUFFIN PHONE: Business Home 704-871-1475

ADDRESS 233 OAK GROVE ROAD, STATESVILLE, NC 28677

LOCATION US 70 ~~EAST~~, TR SLEMON ROAD, TR OAK GROVE ROAD, 2ND LOT ON LEFT

SUBDIVISION SUBURBAN ACRES BLOCK / SECTION LOT 18 LOT AREA 0.5 ACRE SITE CLASS PS DESIGN FLOW 360 L.T.A.R. EXISTING 0.3 GPD/SQ FT

Septic Tank: EXISTING Gallons; STB Date

Pump Tank: Gallons; PT Date

Pump Make: Model Serial No.

Nitrification Field: No Fields 1 Square Feet 540 Linear Feet 180

No Lines TWO Trench Width 36" Max Trench Bottom Depth 36" Gravel Depth ~~24"~~ 12"

☐ New System ☑ Repair System Type: I (II) III, IV, V, VI

System Description:

Repair System Description: CONVENTIONAL, GRAVITY

Maintenance Agreement Required: ☐ Yes ☑ No

☑ House/Mod. Home No. Bedrooms 3

☐ Mobile Home No. Bathrooms 2

☐ Business No. Employees

☐ Other


☐ Slab ☑ Crawl Space ☐ Basement w/plumbing ☐ Basement wo/plumbing

Water Supply: ☐ Individual ☑ Public ☑ Community


Comments:/Conditions: ① REPLACE SANITARY TEE IN SEPTIC TANK IF NECESSARY ② INSTALL NEW DISTRIBUTION BOX AT LOCATION SHOWN FEEDING OLD LINE FIRST, THEN NEW DROP BOX FEEDING TWO NEW LINES

Comments:/Conditions ③ TIE WASHER DRAIN INTO SEPTIC TANK ④ CHECK PLUMBING FOR LEAKS

INITIAL SITE SKETCH ~ SCALE: 1"=40'

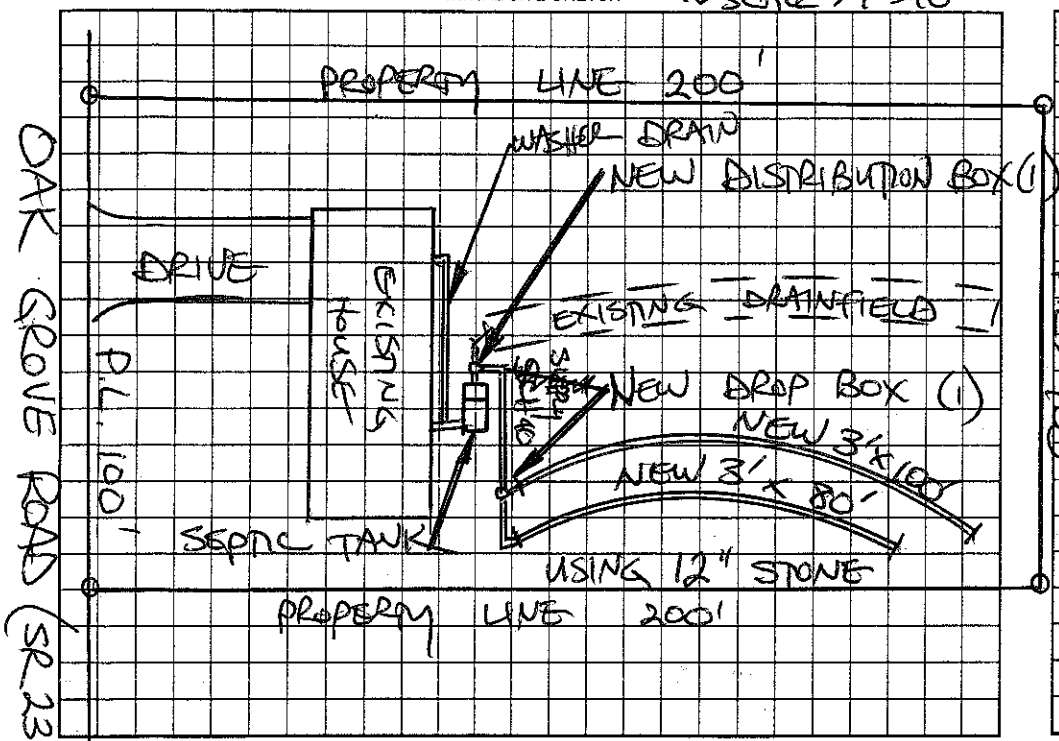

AS BUILT SKETCH

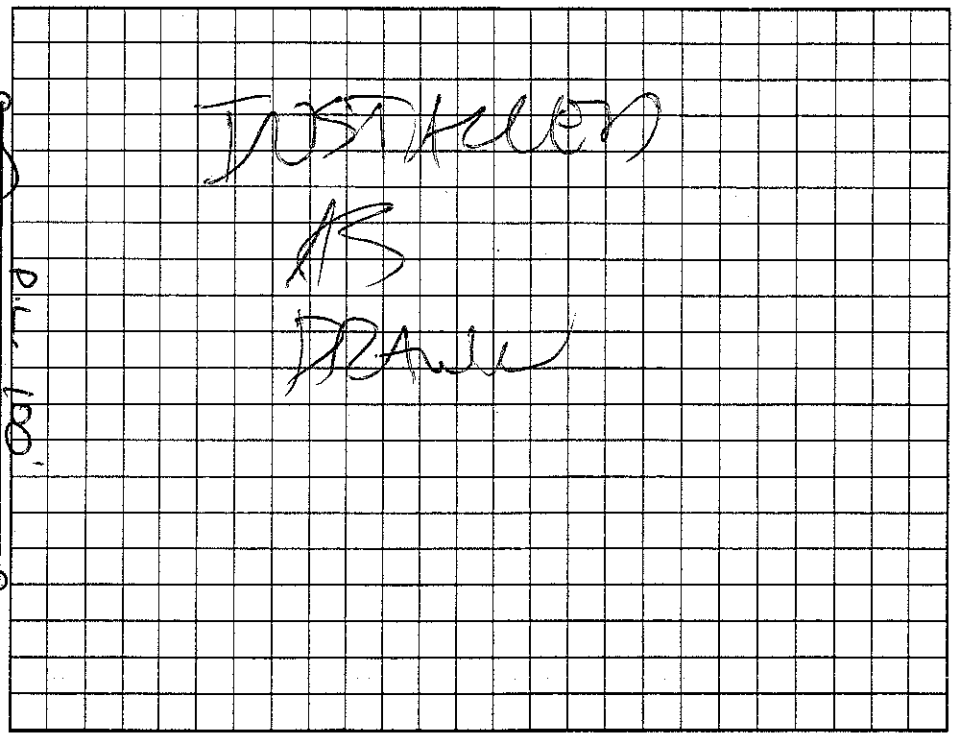

Permit can be suspended or revoked if any false information is supplied toward securing the permit/any unauthorized changes are made to the site/any unauthorized changes are made in the installation of the system. Improvement Permit with plat valid without expiration. Improvement Permit with site plan valid for sixty months. Authorization to Construct is valid for a period equal to that of Improvement Permit – ~~not~~ to exceed sixty months.

Signed: Debra Huffin date 5-24-05 Installed by: Charlie Bell

Improvement Permit by: STEVE HEDRICK date 5-24-05 Operation ~~Permit~~ by: date 7-21-05

Authorization to Construct by: STEVE HEDRICK date 5-24-05 Existing System Inspection by: date

HEALTH DEPT. COPY: WHITE OWNER COPY (FINAL): YELLOW OWNER COPY (INITIAL): PINK