IREDELL COUNTY HEALTH DEPARTMENT Earlier Date

Statesville Phone TR 3-[illegible] Mooresville Phone NO 3-1271

PERMIT TO INSTALL SEPTIC TANK

Permit No. Lot on 131 Permit Date _____ 19__

Owner Hope Brothers Address Statesville

Installed By Lackey Brothers Address Stony Point


Location of Property Salisbury Rd to Rd 2355. Go to 2451. House next to well. Suburban Acres Lot #18

Tank		Capacity		Length of Lines		Fixtures	
Block	( )	1000	( )	225'	( )	No. of Baths	( )
Precast	( )	1250	( )	250'	( )	Dishwasher	( )
		1500	( )	Other 190 extra sq ft.		Garbage Grdr.	( )
		Other _____				Other _____	

NOTIFY HEALTH DEPARTMENT AT LEAST EIGHT HOURS BEFORE TANK IS TO BE INSPECTED.

Final Inspection 5-18-1971 Approved (✓) Disapproved ( )

Remarks Repair to meet FHA 900 sq ft req.

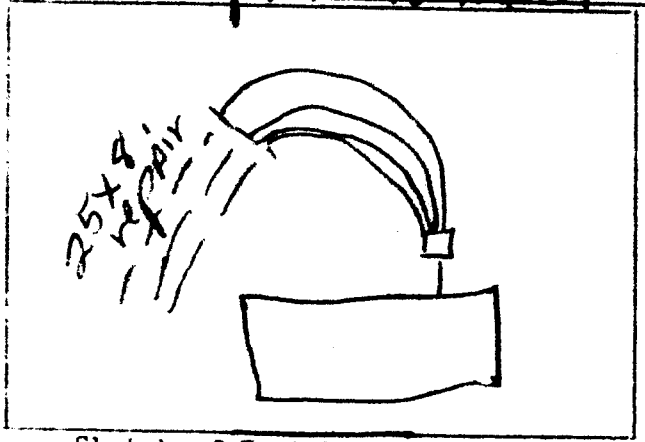

Sketch of Installation

Cross S. Hall
Sanitarian

O well