IREDELL COUNTY HEALTH DEPARTMENT

Statesville Phone TR 3-7271 Mooresville Phone NO 3-1271

PERMIT TO INSTALL SEPTIC TANK

Permit No. 216 Permit Date APRIL 1 1971

Owner HOPE Bros. Builders INC. Address STATESVILLE, NC.

Installed By LACKEY Bros. Address Stony Point, NC

Location of Property

SUBURBAN ACRES


21

Tank		Capacity		Length of Lines		Fixtures	
Block	( )	1000	(✓)	225'	(✓)	No. of Baths	(1)
Precast	(✓)	1250	( )	250'	( )	Dishwasher	( )
		1500	( )	Other		Garbage Grdr.	( )
		Other				Other	

NOTIFY HEALTH DEPARTMENT AT LEAST EIGHT HOURS BEFORE TANK IS TO BE INSPECTED.

Final Inspection April 1 1971 Approved (✓) Disapproved ( )

Remarks Community WATER SUPPLY

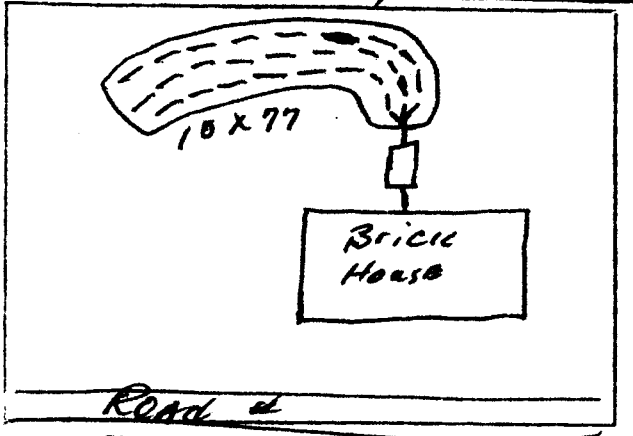

Sketch of Installation

Glenn Lackey Jr.

Sanitarian