IREDELL COUNTY HEALTH DEPARTMENT

STATESVILLE 704-878-5305 MOORESVILLE 704-664-5281

IMPROVEMENT PERMIT / AUTHORIZATION TO CONSTRUCT / OPERATION PERMIT / EXISTING SYSTEM INSPECTION

PERMIT # 15774 PIN # 4753.54 2083 DATE 8-20-09

OWNER or APPLICANT Cuffy Hartley PHONE: Business Home:

OWNER or APPLICANT ADDRESS 248 Sigmon RD Statesville 28677

LOCATION / DIRECTIONS 70 E. TR) Sigmon lot on left

SUBDIVISION Suburban Acres BLOCK / SECTION LOT # 2 LOT AREA DESIGN FLOW 360 L.T.A.R. .25

Septic Tank	Exist	Gallons: STB	Exist	Date	Exist	☑ New System	☐ Repair	☑ Expansion System	Type I II III IV V VI
Pump Tank		Gallons: PT		Date		System Description: 2570 + Gravity correction			
Pump Make		Model		Serial #		Repair System Description: 50% Lay Rock			
Nitrification Field No Fields		No Lines 3		Linear Feet	120 + (240 exist)	Maintenance Agreement Required	☐ YES	☐ NO	
Trench Width	36 + exist	Max. Trench Bottom Depth	36"	Gravel Depth	Exist	☐ GRAVITY	☐ PRESSURE		

☑ Residence	No. Bedrooms	3	Water Supply	
☐ Business	No. Persons		☑ Private	
☐ Other	No. Employees		☐ Public	
☐ Slab	☐ Crawl Space		☐ Community	
☐ Basement w/plumbing	☐ Basement w/o plumbing			


Comments / Conditions

Install or Contour
Maintain all setbacks


Comments / Conditions

Feed 1st thru 3rd line thru elbow into pipe 2 Gallon drop box on last line

INITIAL SITE SKETCH

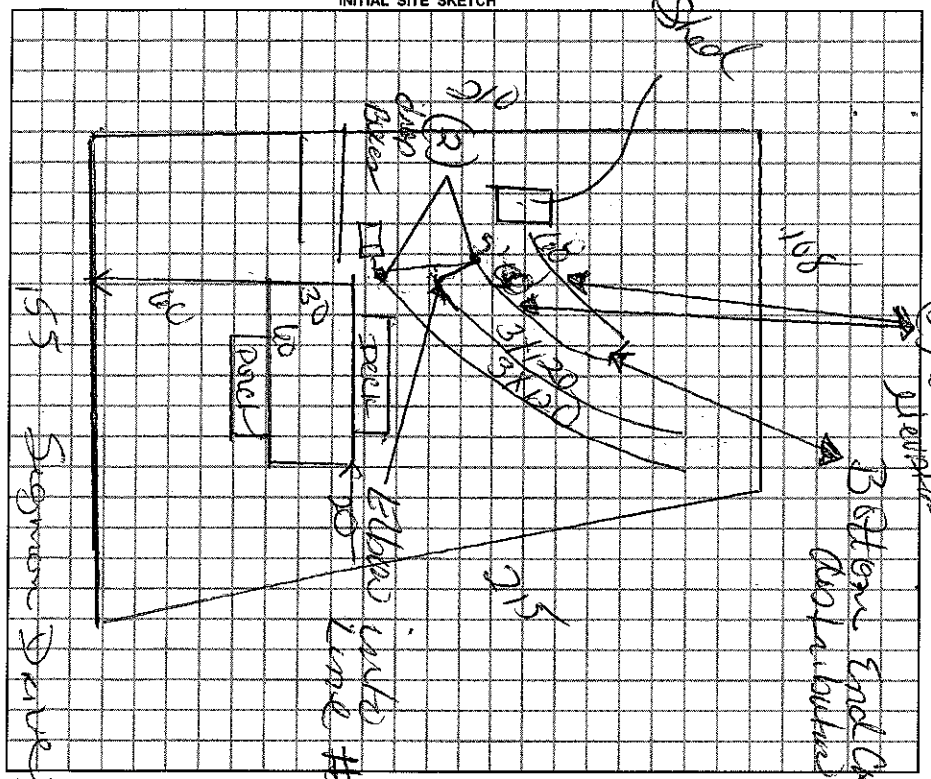

AS BUILT SKETCH

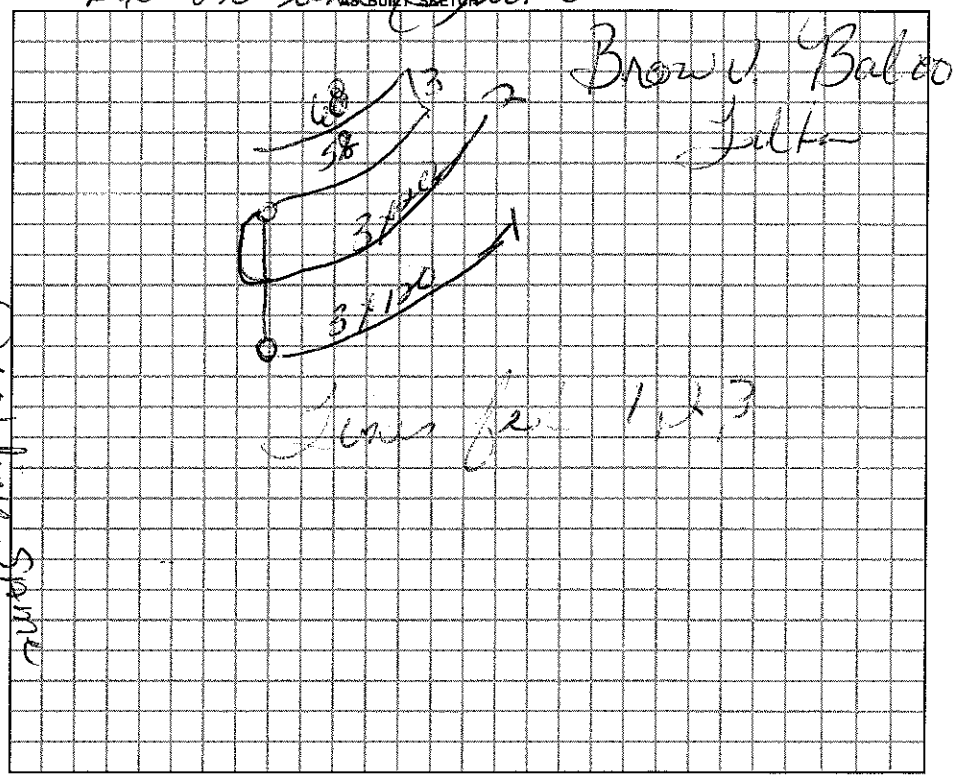

Permit can be suspended or revoked if any false information is supplied toward securing the permit / any unauthorized changes are made to the site / any unauthorized changes are made in the installation of the system.

☐ *IMPROVEMENT PERMIT w / plat valid without expiration.* ☐ *IMPROVEMENT PERMIT w / site plan valid for 60 mos.* ☑ *AUTHORIZATION TO CONSTRUCT valid for period equal to IMPROVEMENT PERMIT-not to exceed 60 mo.*

Owner / Applicant Signature: Danny Tomberlin Date

Improvement Permit by: Date 8-20-09

Authorization to Construct by: Date 8-20-09

Installed by: James Huddle

Operation Permit by: Date: 8-20-09

Existing System Inspected by: Date:

YOU SHOULD CONTACT A LOCATOR SERVICE PRIOR TO ANY EXCAVATION.

WHITE COPY Environmental Health YELLOW COPY (Final) Owner / Applicant PINK COPY (Initial) Owner / Applicant