IREDELL COUNTY HEALTH DEPARTMENT

Statesville Phone TR 3-7271 Mooresville Phone NO 3-1271

PERMIT TO INSTALL SEPTIC TANK

Permit No. 13 Permit Date 4-24 1972

Owner Hope Bros Bldrs Inc. Address Statesville, N.C.

Installed By Hope Bros. Address Statesville, N.C.

Location of Property


Surburban Acres. Lot #19

| Tank | | Capacity | | Length of Lines | | Fixtures | |
|---|---|---|---|---|---|---|---|
| Block | ( ) | 1000 | (✓) | 225' | ( ) | No. of Baths | (✓) |
| Precast | (✓) | 1250 | ( ) | 250' | ( ) | Dishwasher | ( ) |
| | | 1500 | ( ) | Other 300 | | Garbage Grdr. | ( ) |
| | | Other | | 900 S.F. | | Other | |

NOTIFY HEALTH DEPARTMENT AT LEAST EIGHT HOURS BEFORE TANK IS TO BE INSPECTED.

Final Inspection 4-24 1972 Approved (✓) Disapproved ( )

Remarks Community Water Supply

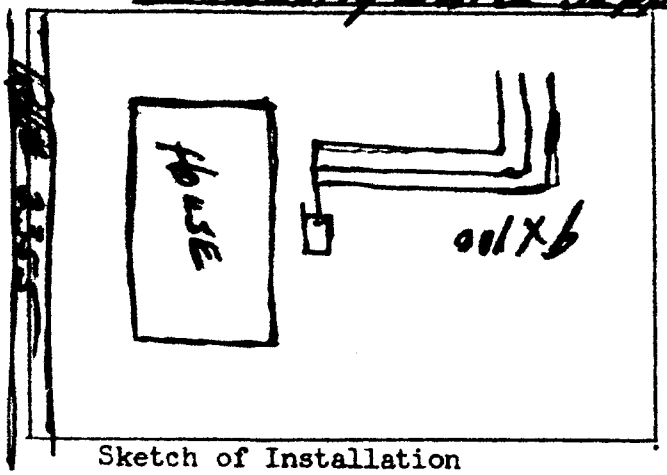


Sketch of Installation

Eleanor Foyle

Sanitarian