IREDELL COUNTY HEALTH DEPARTMENT

STATESVILLE 704-878-5305 MOORESVILLE 704-664-5281

IMPROVEMENT PERMIT / AUTHORIZATION TO CONSTRUCT / OPERATION PERMIT / EXISTING SYSTEM INSPECTION

PERMIT# 94574 PIN# 4755543817 DATE 8-20-07

OWNER OR APPLICANT Gary + Terry Gibson PHONE: Business 704-856-8205 Home

ADDRESS 201 Sigmon RD Statesville NC 28677

LOCATION 70E TR Third Creek RD Palmer RD Sigmon house on left

SUBDIVISION Suburban Acres BLOCK / SECTION LOT 35 LOT AREA SITE CLASS. PS DESIGN FLOW 240 L.T.A.R. .3

Septic Tank: 1000 Gallons; STB Date 9-15-07

Pump Tank: Gallons; PT Date

Pump Make: Model Serial No.

Nitrification Field: No Fields Square Feet 800 Linear Feet 200

No Lines 2 Trench Width 36" Max Trench Bottom Depth 36" Gravel Depth N/A ☑ Gravity ☐ Pressure

☑ New System ☐ Repair ☐ Expansion System Type: I (II) III IV V VI

System Description: 25% Gravel

Repair System Description: 1945 (C) D

Maintenance Agreement Required: ☐ Yes ☐ No

☑ House/Mod. Home ☐ Mobile Home ☐ Business ☐ Other

No. Bedrooms 2 No. Persons No. Employees


Water Supply: ☐ Individual ☐ Public ☑ Community

☐ Slab ☑ Crawl Space ☐ Basement w/plumbing ☐ Basement wo/plumbing

Comments:/Conditions:

Comments:/Conditions: Orange - Brown Balcone

INITIAL SITE SKETCH

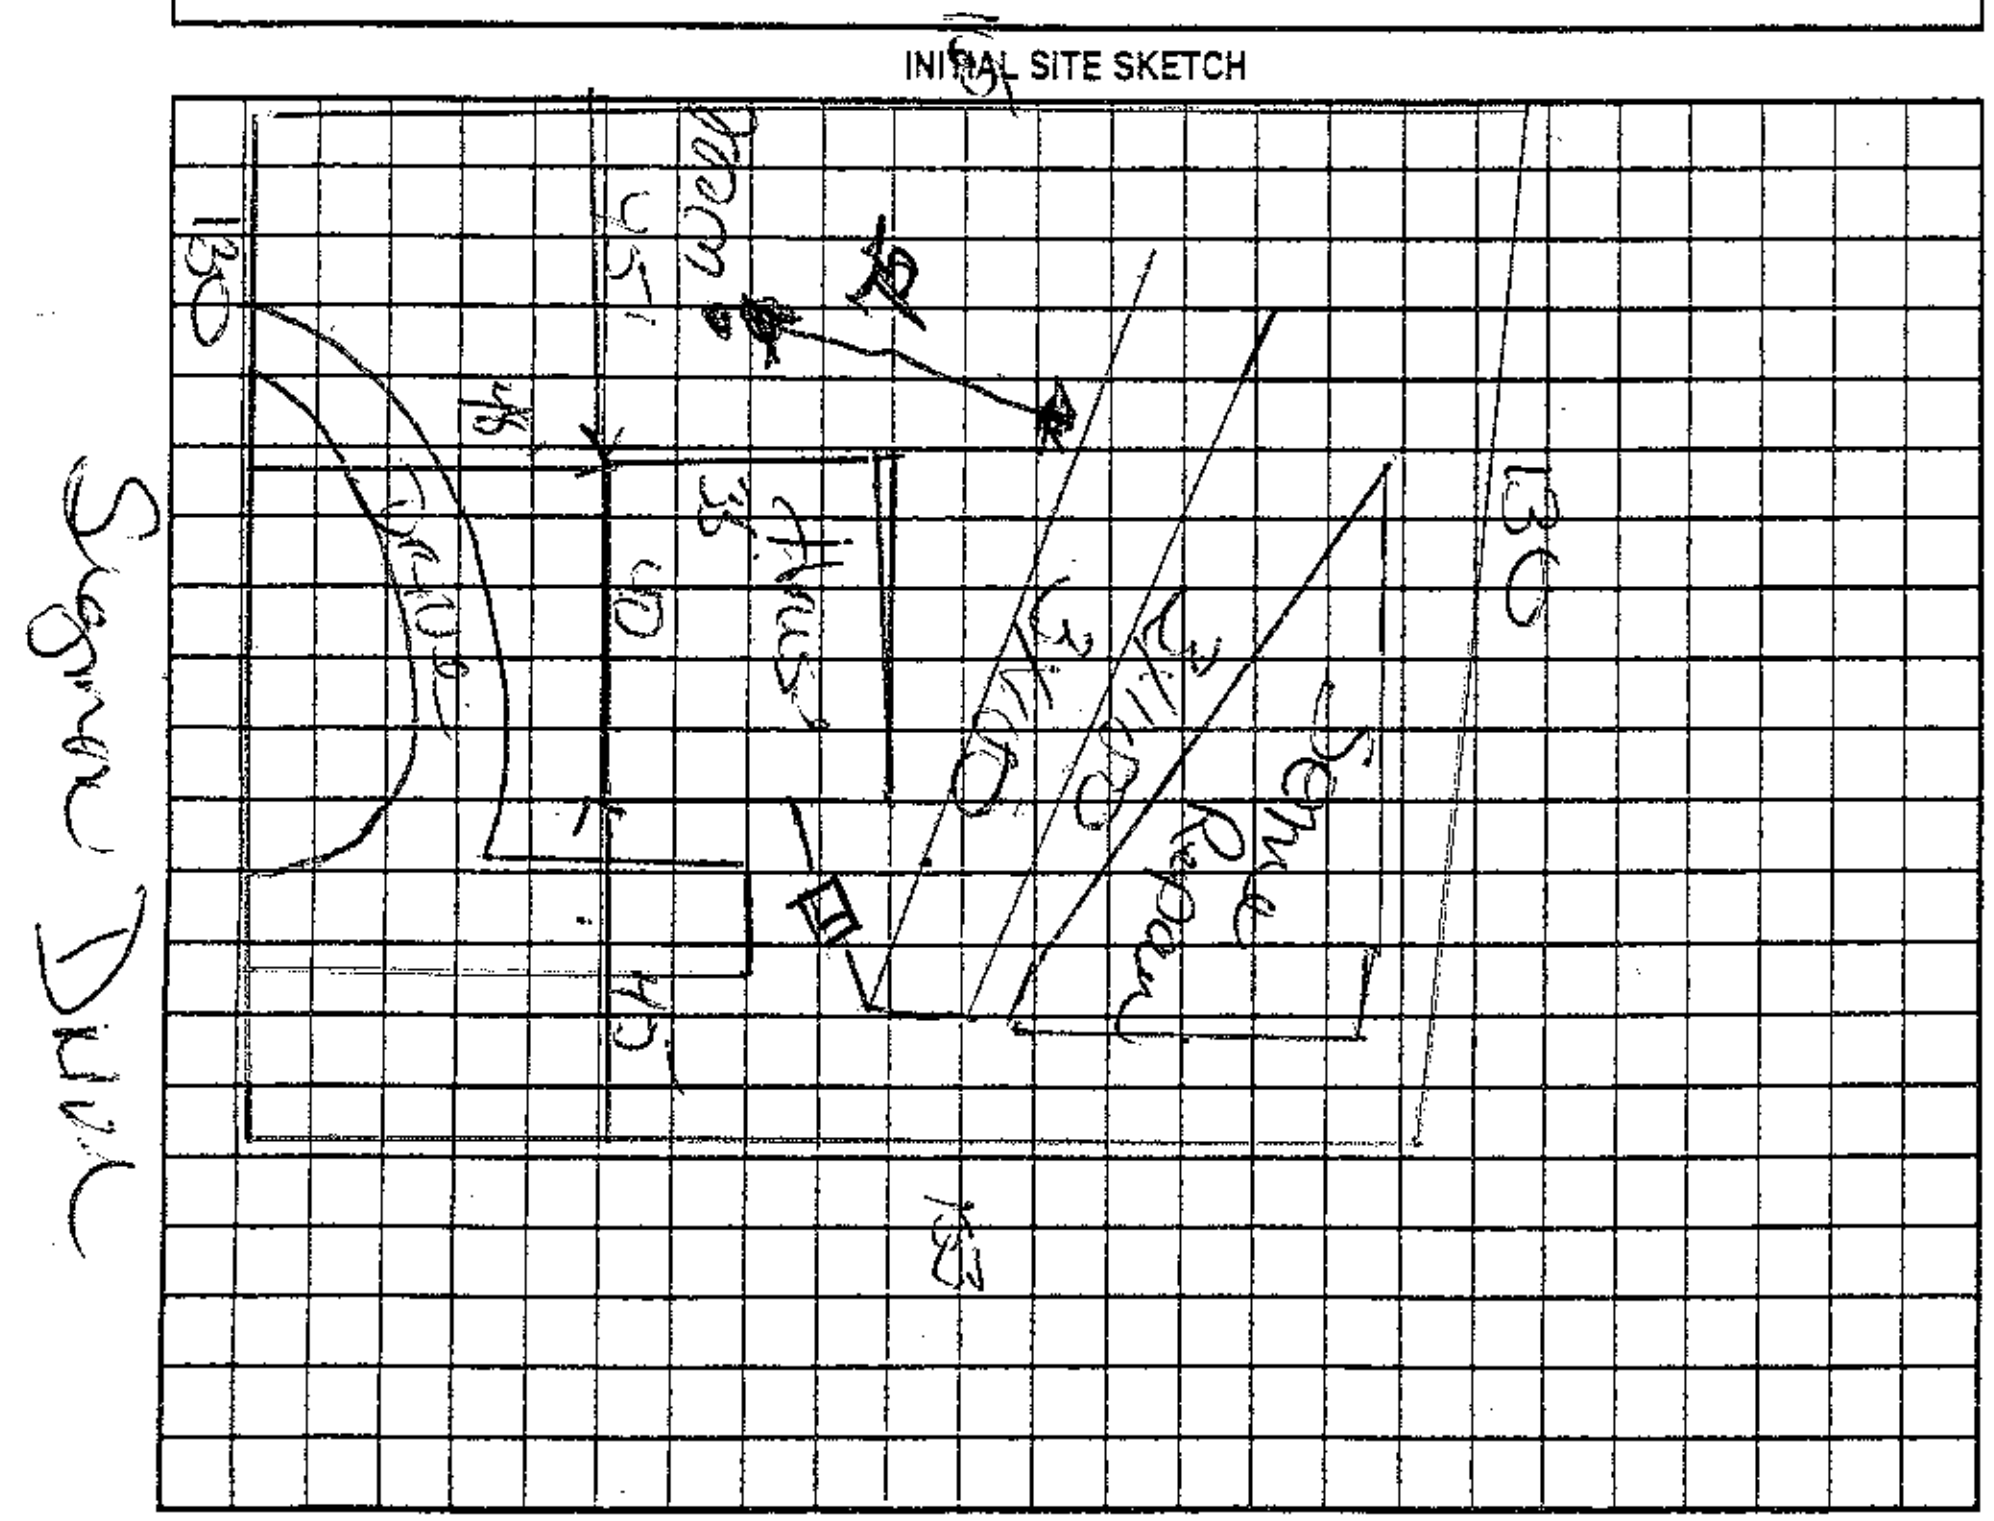

AS BUILT SKETCH

Permit can be suspended or revoked if any false information is supplied toward securing the permit/any unauthorized changes are made to the site/any unauthorized changes are made in the installation of the system. Improvement Permit with plat valid without expiration ☐ Improvement Permit with site plan valid for sixty months ☐ Authorization to Construct is valid for a period equal to that of Improvement Permit – not to exceed sixty months.

Signed: Michael L. Deinhart 8/20/2007 date

Improvement Permit by: Kirk Cook date 8-20-07

Authorization to Construct by: Kirk Cook date 8-20-07

Installed by: James Hudler

Operation Permit by: Kirk Cook date 10-31-07

Existing System Inspection by: date

HEALTH DEPT. COPY: WHITE OWNER COPY (FINAL): YELLOW OWNER COPY (INITIAL): PINK