IREDELL COUNTY HEALTH DEPARTMENT

STATESVILLE 704-878-5305 MOORESVILLE 704-664-5281

IMPROVEMENT PERMIT / CERTIFICATE OF COMPLETION / OPERATION PERMIT / EXISTING SYSTEM INSPECTION

PROPERTY DESCRIPTION NO. _____ DATE 6-4-97 TAX MAP NO. _____ Watershed: ☐ Yes ☐ No

OWNER OR CONTRACTOR Melvin Wattell PHONE: Business _____ Home 872-0569

ADDRESS 251 Sigmon Rd

LOCATION 70E IR Sigmon Dr. after 3rd Creek Rd 1/2 mi left corner Haunt Ln.

SUBDIVISION _____ BLOCK / SECTION _____ LOT _____ LOT AREA 1/2 acre SITE CLASS. _____ DESIGN FLOW _____ L.T.A.R. _____

Septic Tank: Ex. Gallons; STB _____ Date _____

Pump Tank: _____ Gallons; PT _____ Date _____

Pump Make: _____ Model _____ Serial No. _____

Nitrification Field: No Fields 1 Square Feet 450 Linear Feet 150

No Lines 2 Trench Width 22" Max Trench Bottom Depth 36" Gravel Depth 18"

☐ New System ☑ Repair System Type: I, II, III, IV, V, VI

System Description: _____

Repair System Description: Conv. Gravity

Maintenance Agreement Required: ☐ Yes ☐ No

☐ House/Mod. Home ☑ Mobile Home ☐ Business ☐ Other

No. Bedrooms 3 No. Bathrooms 2 No. Employees _____

☐ Slab ☑ Crawl Space ☐ Basement w/plumbing ☐ Basement wo/plumbing


Water Supply: ☐ Individual ☐ Community ☑ Public

Comments:


Check For + Repair any + all Plumbing leaks.

Comments:

INITIAL SITE SKETCH Croft Ln.

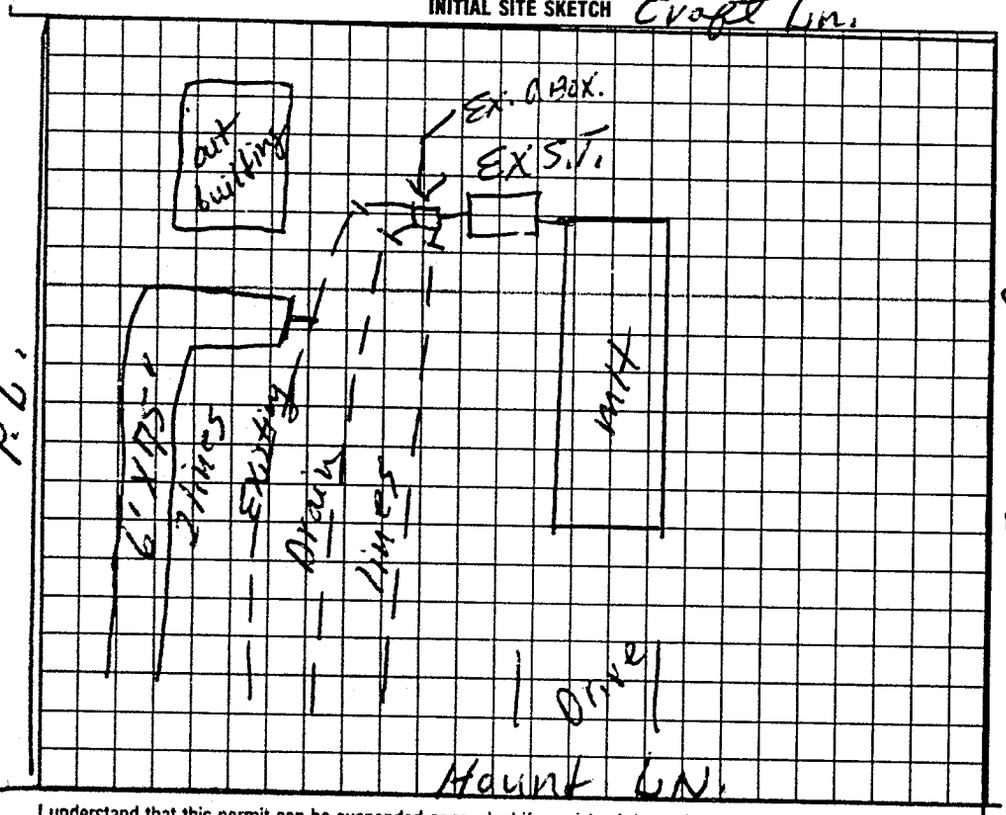

AS BUILT SKETCH

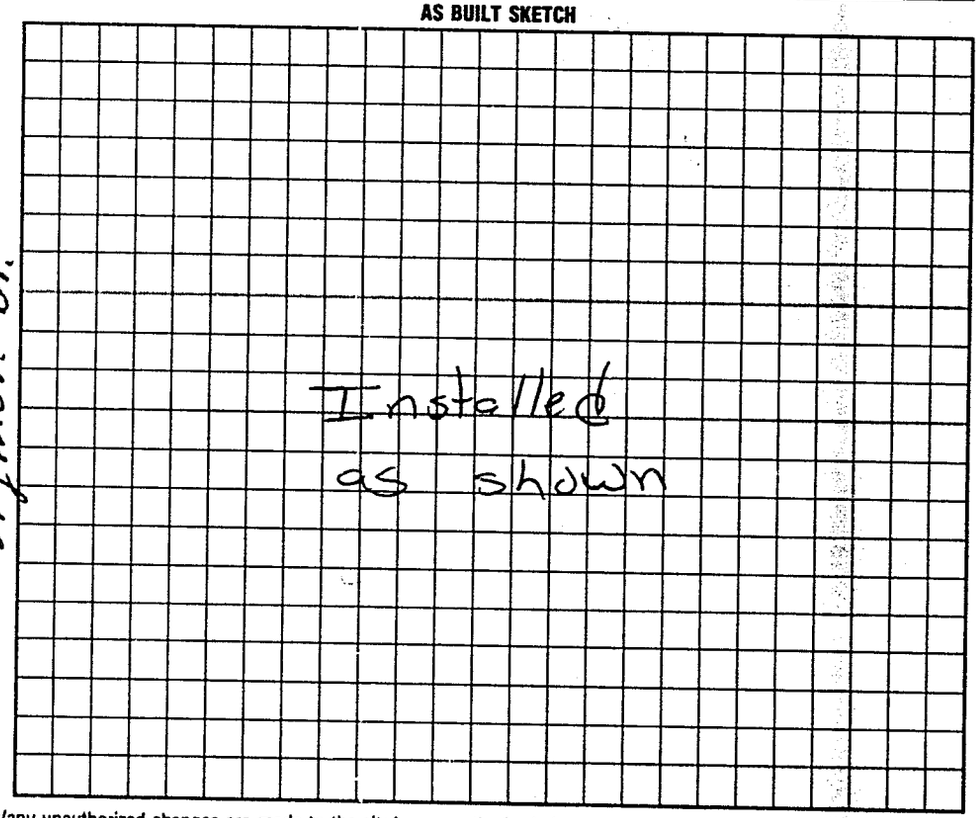

I understand that this permit can be suspended or revoked if any false information is supplied toward securing the permit/any unauthorized changes are made to the site/any unauthorized changes are made in the installation of the system. Improvement Permit is valid for 60 months from date of issuance.

Signed: _____

Improvement Permit by: P. C. Moore date 6-4-97

Existing System Authorization by: P. C. Moore date 6-4-97

Authorization to Count

Installed by: Donald Lackey

Certificate of Completion by: _____ date _____

Operation Permit by: _____ date 5-18-98

HEALTH DEPT. COPY: WHITE INSPECTION COPY (FINAL): GREEN OWNER COPY (FINAL): YELLOW INSPECTION COPY (INITIAL): PINK OWNER COPY (INITIAL): GOLD

Authorization to Count Expires 60 mos From issue

659 00