IREDELL COUNTY HEALTH DEPARTMENT

STATESVILLE 704-878-5305 (1) MOORESVILLE 704-664-5281

(1) IMPROVEMENT PERMIT / AUTHORIZATION TO CONSTRUCT / OPERATION PERMIT / EXISTING SYSTEM INSPECTION

PERMIT# 110239 PIN# 4753-54-5109 DATE 2-7-03

OWNER OR CONTRACTOR JUAN NUNEZ PHONE: Business 704-682-1412 Home

ADDRESS 241 SIGMON ROAD, STATESVILLE, NC 28677

LOCATION US 70 EAST, TR SIGMON ROAD, LOT ON LEFT AT HOUND LANE

SUBDIVISION LACKEY BLOCK / SECTION LOT 1 LOT AREA 0.45 ACRE SITE CLASS. PS DESIGN FLOW 360 L.T.A.R. 0.25 GPD/FT²

Septic Tank: 1000 Gallons; STB 1007 Date 9-16-02
Pump Tank: Gallons; PT Date
Pump Make: Model Serial No.
Nitrification Field: No Fields 1 Square Feet 1440 Linear Feet 240
No Lines SIX Trench Width 24" Max Trench Bottom Depth 36" ~~Gutter~~ Depth SAND 6"

☑ New System ☐ Repair System Type: I, II, (III), IV, V, VI
System Description: 50% REDUCTION, GRAVITY
Repair System Description: 50% REDUCTION, LOW PRESSURE
Maintenance Agreement Required: ☐ Yes ☒ No

☐ House/Mod. Home ☑ Mobile Home ☐ Business ☐ Other
No. Bedrooms 3 No. Bathrooms 2 No. Employees


☐ Slab ☑ Crawl Space ☐ Basement w/plumbing ☐ Basement wo/plumbing

Water Supply: ☑ Individual ☐ Public ☐ Community WELL

Comments:/Conditions: (1) KEEP SYSTEM MAXIMUM FEASIBLE DISTANCE (85') FROM WELL (2) INSTALL 50% REDUCTION SYSTEM USING 54 PPBPS PANELS (3) USE ONE FLOW DIVIDER TEE TO ACHIEVE EQUAL DISTRIBUTION INTO TWO DISTRIBUTION BOXES FEEDING THREE LINES EACH.

Comments:/Conditions: SEPTIC TANK WITH MARKER INSTALLED USING "PolyLok" FILTER

INITIAL SITE SKETCH SCALE: 1" = 40'

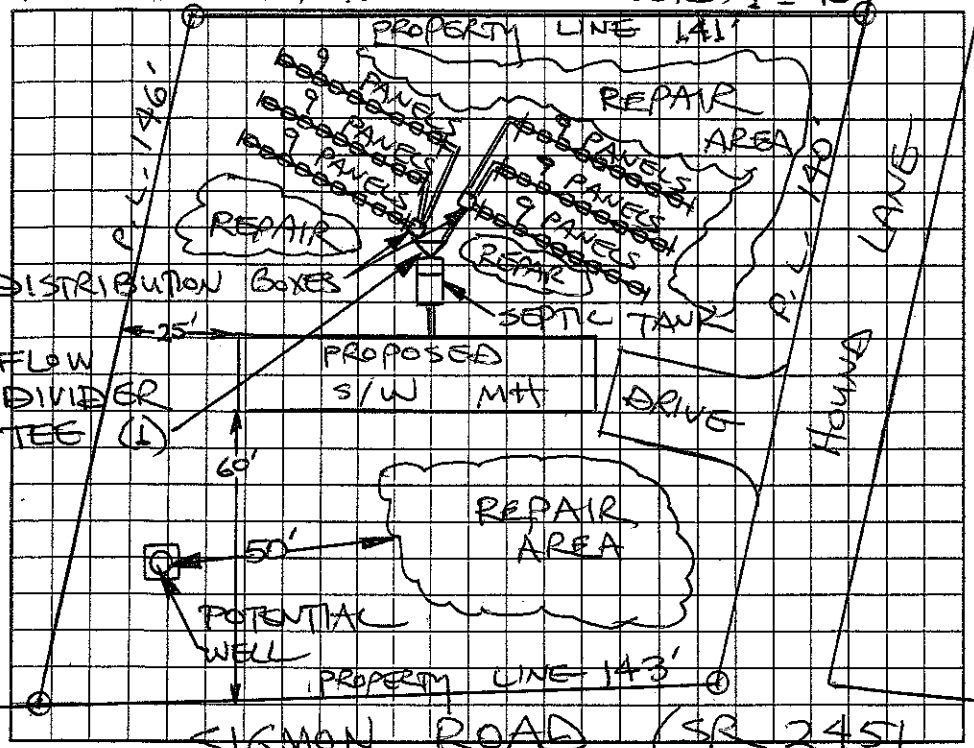

AS BUILT SKETCH

SYSTEM INSTALLED ACCORDING TO INITIAL SITE SKETCH

Permit can be suspended or revoked if any false information is supplied toward securing the permit/any unauthorized changes are made to the site/any unauthorized changes are made in the installation of the system. Improvement Permit with plat valid without expiration. Improvement Permit with site plan valid for sixty months. Authorization to Construct is valid for a period equal to that of Improvement Permit – not to exceed sixty months.

Signed: X JUAN NUNEZ date 2-10-03 Installed by: SCOTT GREENE

Improvement Permit by: STEVE HEDRICK date 2-7-03 Operation Permit by: STEVE HEDRICK date 2-14-03

Authorization to Construct by: STEVE HEDRICK date 2-7-03 Existing System Inspection by: date

HEALTH DEPT. COPY: WHITE OWNER COPY (FINAL): YELLOW OWNER COPY (INITIAL): PINK