IREDELL COUNTY HEALTH DEPARTMENT

STATESVILLE 704-878-5305 MOORESVILLE 704-664-5281

IMPROVEMENT PERMIT / AUTHORIZATION TO CONSTRUCT / OPERATION PERMIT / EXISTING SYSTEM INSPECTION

PERMIT# Repair PIN# 4753-54-6551 DATE 1-24-06

OWNER OR CONTRACTOR Christina Gardner PHONE: Business Home 704-253-5623

ADDRESS 213 Oak Grove Rd

LOCATION Hwy 70 E. R on Oak Grove Rd.

SUBDIVISION ~~Pine~~ Suburban Acres BLOCK/SECTION n/a LOT 39 LOT AREA ~.8 SITE CLASS. PS DESIGN FLOW 360 L.T.A.R. .3

Septic Tank: 1000 Gallons; STB Date

Pump Tank: Gallons; PT Date

Pump Make: Model Serial No.

Nitrification Field: No Fields 1 Square Feet 1200 Linear Feet 320

No Lines 3 Trench Width 3 Max Trench Bottom Depth 36" Gravel Depth n/a

☐ New System ☒ Repair System Type: I II III IV V VI

System Description: 25% Reduction Gravity

Repair System Description:

Maintenance Agreement Required: ☐ Yes ☒ No

☒ House/Mod. Home No. Bedrooms 3

☐ Mobile Home No. Bathrooms

☐ Business No. Employees

☐ Other

☐ Slab ☐ Crawl Space ☒ Basement w/plumbing ☐ Basement wo/plumbing


Water Supply: ☐ Individual ☒ Public ☒ Community

Comments:/Conditions:


* Replumb to separate upper and lower floor New system will cover upper floor only
* Check all plumbing for leaks
* Reduce water usage
* Install low-flow water fixtures
* Try to allow lower system to rest by using upper system more initially

Comments:/Conditions: on separate system

INITIAL SITE SKETCH

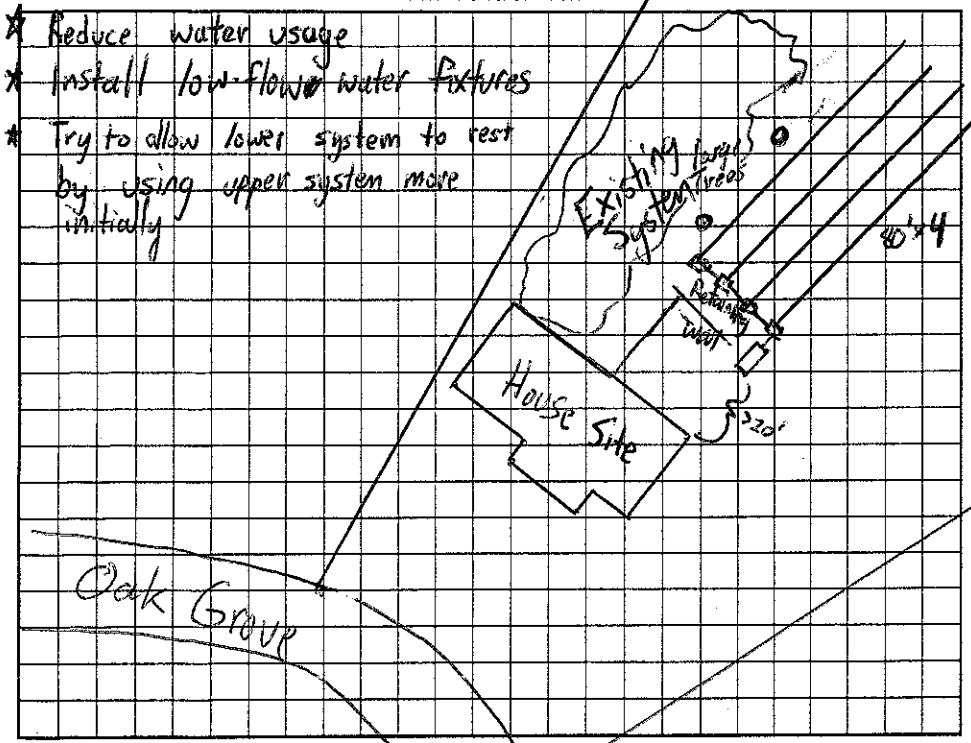

AS BUILT SKETCH

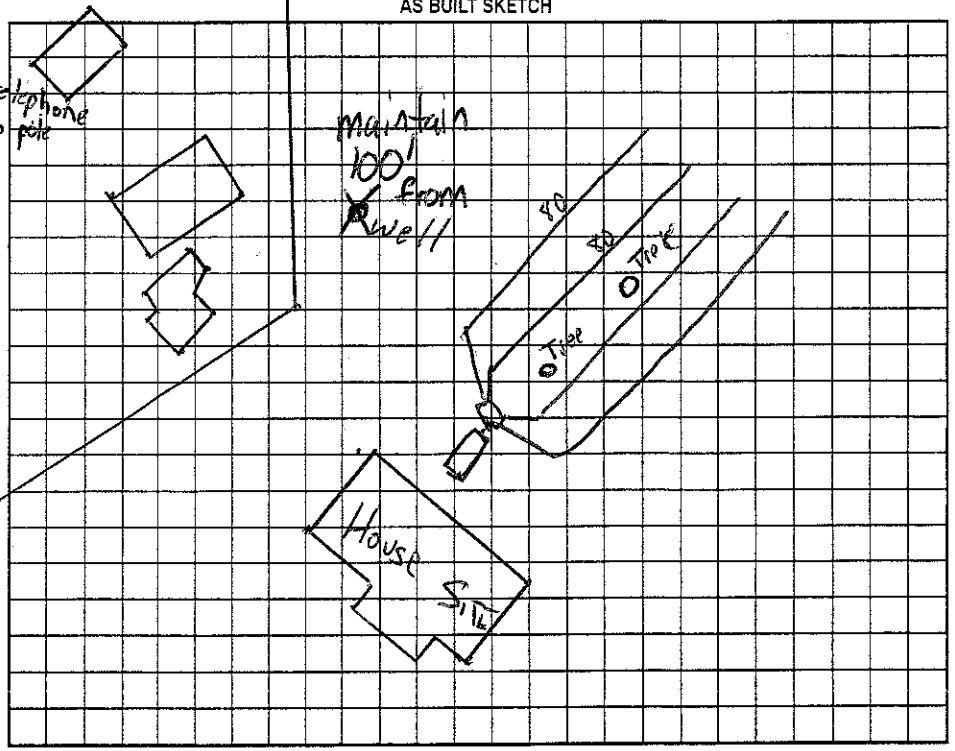

Permit can be suspended or revoked if any false information is supplied toward securing the permit/any unauthorized changes are made to the site/any unauthorized changes are made in the installation of the system. Improvement Permit with plat valid without expiration. Improvement Permit with site plan valid for sixty months. Authorization to Construct is valid for a period equal to that of Improvement Permit – not to exceed sixty months.

Signed: Christina Gardner date

Improvement Permit by: date 1-24-06

Authorization to Construct by: date

Installed by: Craig Thompson

Operation Permit by: date 1-24-06

Existing System Inspection by: date

HEALTH DEPT. COPY: WHITE OWNER COPY (FINAL): YELLOW OWNER COPY (INITIAL): PINK