IREDELL COUNTY HEALTH DEPARTMENT

Statesville Phone TR 3-7271

Mooresville Phone NO 3-1271

PERMIT TO INSTALL SEPTIC TANK

Permit No. _____

Permit Date 7-2 1973

Owner Hope Bro Address Statesville N.C.

Installed By Hope Bro Address Statesville N.C.

Location of Property

Suburban Acres Lot # 39


House on R. Below Poole Refrigeration

Tank		Capacity		Length of Lines		Fixtures	
Block	( )	1000	(✓)	225'	(✓)	No. of Baths	(1½
Precast	(✓)	1250	( )	250'	( )	Dishwasher	( )
		1500	( )	Other _____		Garbage Grdr.	( )
		Other _____				Other _____	

NOTIFY HEALTH DEPARTMENT AT LEAST EIGHT HOURS BEFORE TANK IS TO BE INSPECTED.

Final Inspection 7-2 1973 Approved (✓) Disapproved ( )

Remarks Community Water

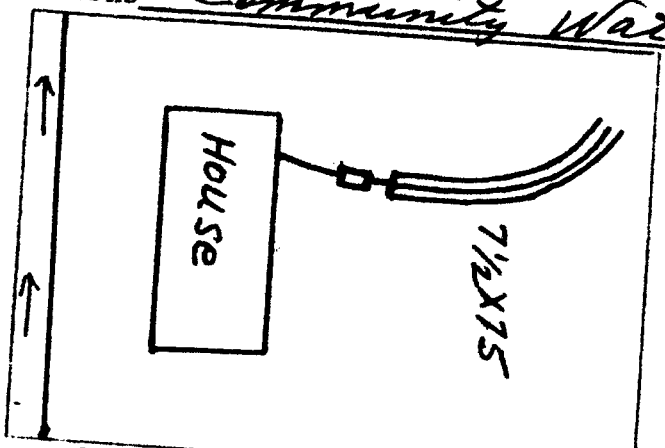

Sketch of Installation

Tank and lines are deep!!

E. G. Stevenson

Sanitarian