IREDELL COUNTY HEALTH DEPARTMENT

STATESVILLE 704-878-5305 MOORESVILLE 704-664-5281

IMPROVEMENT PERMIT / CERTIFICATE OF COMPLETION / OPERATION PERMIT / EXISTING SYSTEM INSPECTION

PROPERTY DESCRIPTION NO. 16420 DATE 9-22-93 TAX MAP NO. 5L-10-A-7

OWNER OR CONTRACTOR Donald Lackey Sr. PHONE: Business Home 872-7225

ADDRESS Rt 15 Box 104 Statesville

LOCATION 70E to Thistlecreek Rd TL Palmer Rd TR Sigmon Dr. TL Haunt Dr. 500' on Rt + Left

SUBDIVISION Donald Lackey Property BLOCK / SECTION 1 LOT 7+4 LOT AREA 30,000 SF+ SITE CLASS. PS L.T.A.R. .33

Water Supply: ☐ Individual ☐ Community ☒ Public

Septic Tank: 1000 Gallons: STB 358 Date 8-10-93

Pump Tank: ____ Gallons: PT ____ Date ____

Nitrification Field: No Fields 1 Square Feet 720 Linear Feet 240

No Lines 2 Trench Width 36 Trench Depth 18+36 Gravel Depth 12

☒ New System ☐ Repair System Type: I. II. III. IV. V. VI

System Description: conv Gravity

Repair System Description: Conv. Pump

Maintenance Agreement Required: ☐ Yes ☒ No

☐ House/Mod. Home ☒ Mobile Home ☐ Business ☐ Other

No. Bedrooms 2 No. Bathrooms 2 No. Employees ____

☐ Slab ☒ Crawl Space ☐ Basement w/plumbing ☐ Basement wo/plumbing

Garbage Disposal: ☐ Yes ☒ No


Auto. Dishwasher: ☐ Yes ☒ No

Auto. Washing Machine: ☐ Yes ☐ No


Other ____

Comments Both lots to be used for one Home site

INITIAL SITE SKETCH

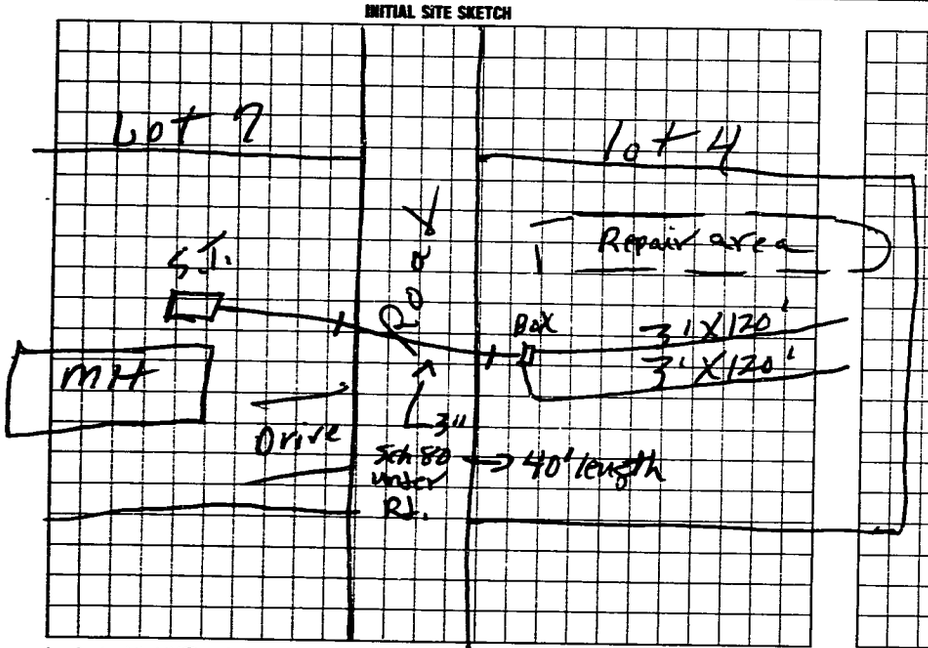

AS BUILT SKETCH

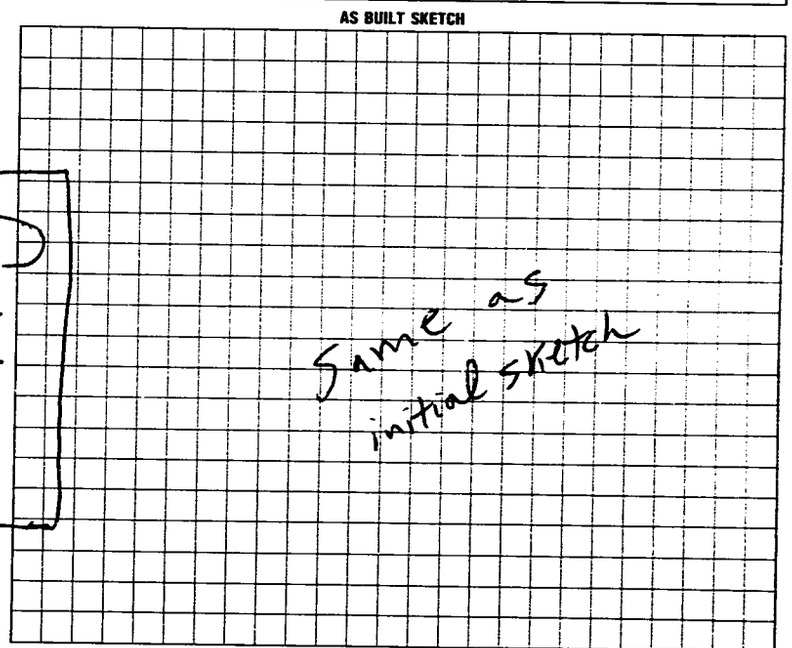

I understand that this permit can be suspended or revoked if any false information is supplied toward securing the permit/any unauthorized changes are made to the site/any unauthorized changes are made in the installation of the system. Improvement Permit is valid for 60 months from date of issuance.

Signed: x Donald Lackey Jr.

Improvement Permit by: E. C. Moore date 9-22-93

Existing System Inspection by: ____ date ____

Installed by: Donald Lackey

Certificate of Completion by: E. C. Moore date 9-24-93

Operation Permit by: ____ date ____

HEALTH DEPT. COPY: WHITE INSPECTION COPY (FINAL): GREEN OWNER COPY (FINAL): YELLOW INSPECTION COPY (INITIAL): PINK OWNER COPY (INITIAL): GOLD