IREDELL COUNTY HEALTH DEPARTMENT

Statesville Office (704) 878-5305 Mooresville Office (704) 660-3625 PERMIT # 181696

IMPROVEMENT PERMIT / AUTHORIZATION TO CONSTRUCT / OPERATION PERMIT / EXISTING SYSTEM

PIN # 4753551397

APPLICANT: Timothy Cove APPLICANT ADDRESS: 181 Sigmon Rd

SITE ADDRESS: 181 Sigmon Rd PHONE: 704-929-4515 ALT. PHONE: N/A


SITE DIRECTIONS: Hwy 70 E TR Third Creek Rd TL Palmer 181 Sigmon across from stop sign

SUBDIVISION: Suburban Acres SECTION: N/A LOT # 30-31 LOT AREA: 1.05 acres DESIGN FLOW: 360gpd L.T.A.R.: Existing


Septic Tank	1000 (gal)	STB	66-1000	Date	3-31-14	☐ New System ☐ Repair ☐ Expansion	System Type: I (II) III IV V VI	☑ Residence	No. Bedrooms 3	Water Supply
Pump Tank	(gal)	PT		Date		System Description:	Conventional Bed	☐ Business	No. Persons 6	☐ Private
Pump Make		Model		Serial #		Repair System Description:		☐ Other	No. Employees	☑ Public
# Nitrification Fields	1	# Lines	6x	Linear Ft:	6x	Maintenance Agreement Required:	☐ YES ☑ NO	☐ Slab	☑ Crawl Space	☐ Community
Trench Width	6x	Max. Trench Bottom Depth	6x	Gravel Depth	6x		☑ GRAVITY ☐ PRESSURE	☐ Basement w/plumbing	☐ Basement w/o plumbing	

Comments / Conditions: Set new septic tank @ location shown below + connect to existing drainfield. Pump + crush existing septic tank. Remove Asphalt Drive over drainfield @ locations shown below + area shall remain natural + not utilized for driveway.

INITIAL SITE SKETCH

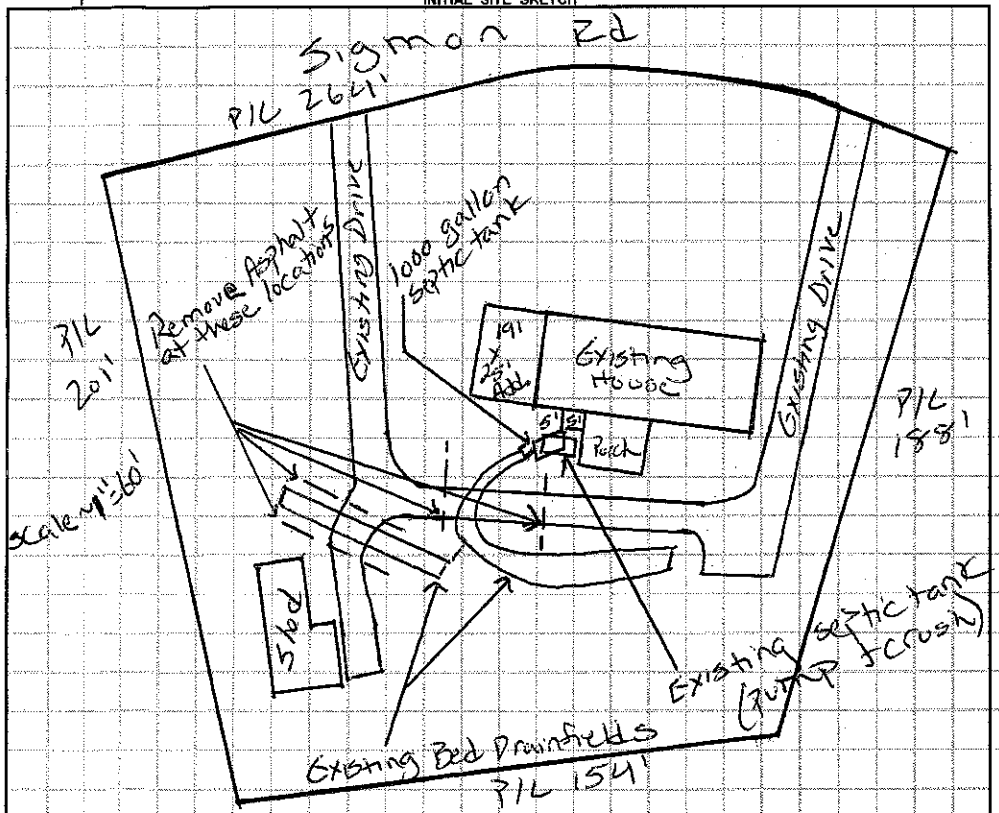

AS BUILT SKETCH

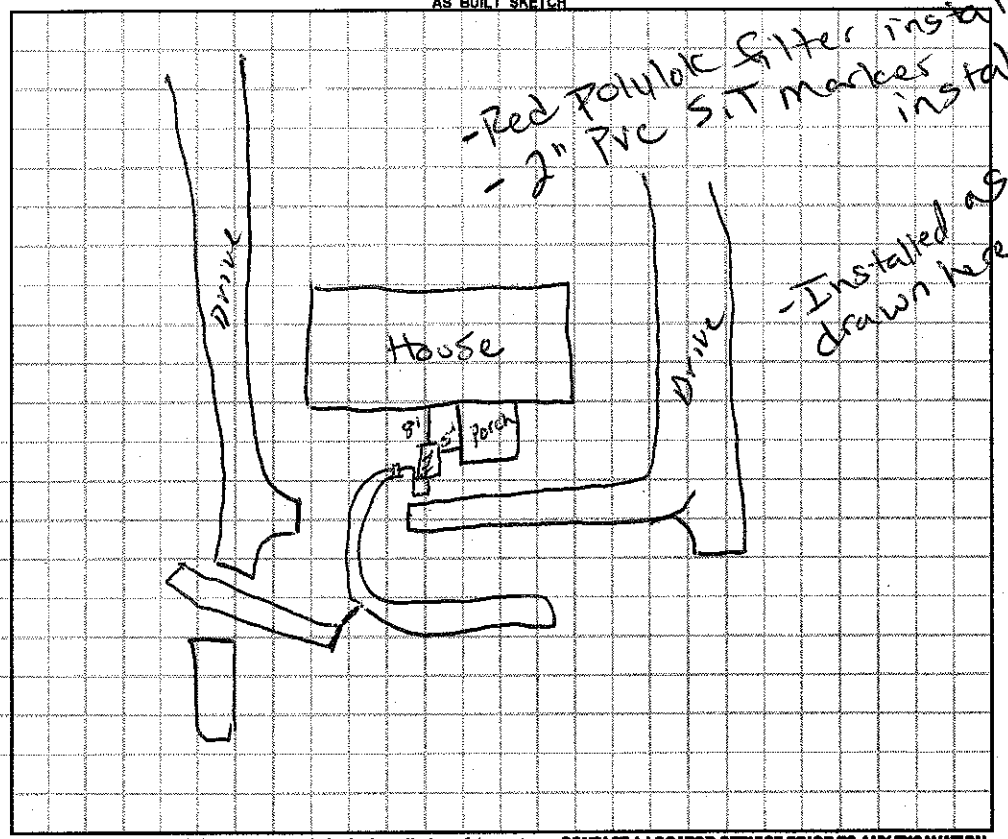

Permit can be suspended or revoked if any false information is supplied toward securing the permit / any unauthorized changes are made to the site / any unauthorized changes are made in the installation of the system. **CONTACT A LOCATOR SERVICE PRIOR TO ANY EXCAVATION**

☐ **IMPROVEMENT PERMIT** *with plat* valid without expiration. ☑ **IMPROVEMENT PERMIT** *with site plan* valid for 60 mos. ☑ **AUTHORIZATION TO CONSTRUCT** valid for period equal to IMPROVEMENT PERMIT--not to exceed 60 mo.

Owner / Applicant Signature: Date: 4-29-14 Installed by: K + M Grading

IMPROVEMENT PERMIT by: Justin Henderson Date: 4-29-14 OPERATION PERMIT by: Justin Henderson Date: 5-9-14

AUTHORIZATION TO CONSTRUCT by: Justin Henderson Date: 4-29-14 Existing System Inspected by: Date:

Health Dept. Copy - WHITE Applicant (Final Approval) - YELLOW Applicant (Conditional Approval) - PINK