IREDELL COUNTY HEALTH DEPARTMENT

Statesville Office (704) 878-5305 Mooresville Office (704) 660-3625 PERMIT # 202434

IMPROVEMENT PERMIT / AUTHORIZATION TO CONSTRUCT / OPERATION PERMIT / EXISTING SYSTEM

PIN # 4753552221

APPLICANT: James Davidson APPLICANT ADDRESS: 193 Sigmon Rd Statesville NC

SITE ADDRESS: 193 Sigmon Rd Statesville NC 28677 PHONE: 704-873-7671 ALT. PHONE: N/A

SITE DIRECTIONS: I-40 E T/R Three Creek Rd T/L Palmer Rd


SUBDIVISION: Surburban Acres SECTION: N/A LOT # 5532 LOT AREA: 0.49ac DESIGN FLOW: 360 L.T.A.R.: .375

Septic Tank	Existing	(gal)	STB	N/A	Date	N/A	☐ New System	☒ Repair	☐ Expansion	System Type: I II (III) IV V VI	
Pump Tank	N/A	(gal)	PT	N/A	Date	N/A	System Description:	25% Reduction			
Pump Make	N/A		Model	N/A	Serial #	N/A	Repair System Description:	N/A			
# Nitrification Fields	1		# Lines	4	Linear Ft:	328	Maintenance Agreement Required:	☐ YES	☒ NO		
Trench Width	36"		Max. Trench Bottom Depth	36"			Gravel Depth	N/A	☒ GRAVITY	☐ PRESSURE	


☒ Residence	No. Bedrooms	3	Water Supply
☐ Business	No. Persons	6	☐ Private
☐ Other	No. Employees		☐ Public
☐ Slab	☐ Crawl Space		☒ Community
☒ Basement w/plumbing			☐ Basement w/o plumbing

Comments / Conditions: Check tank, check tee, replace if necessary. Install 25% Reduction on Contour with Serial distribution.

INITIAL SITE SKETCH

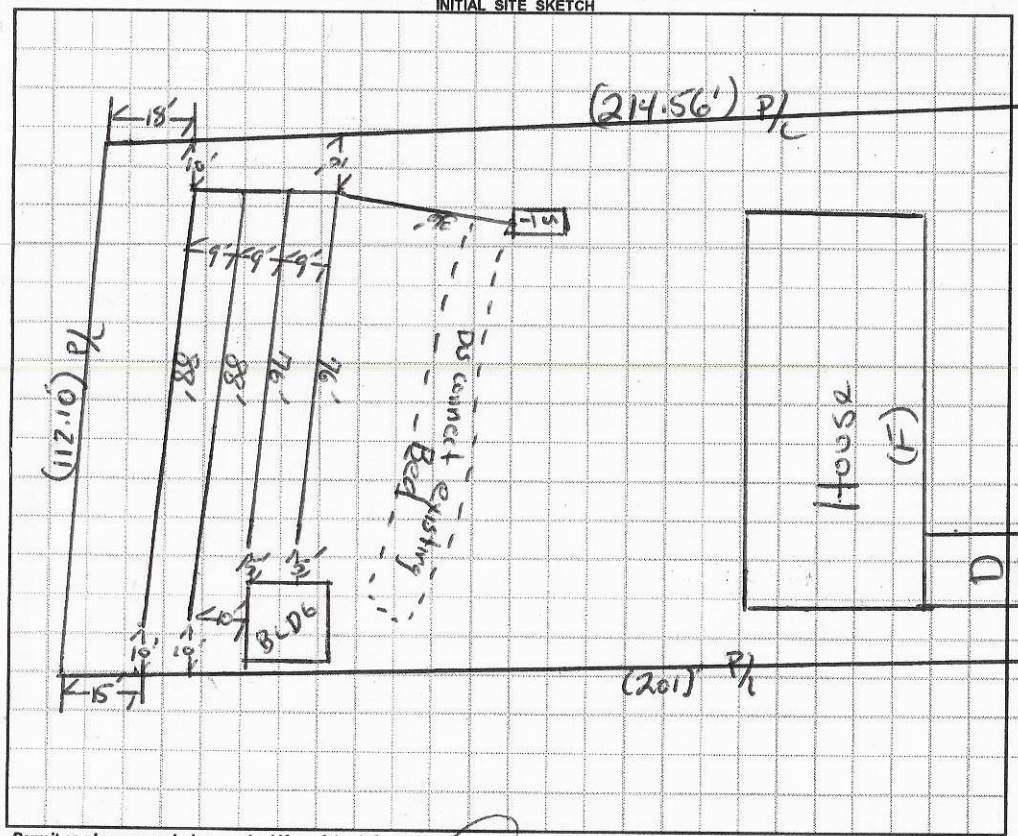

AS BUILT SKETCH

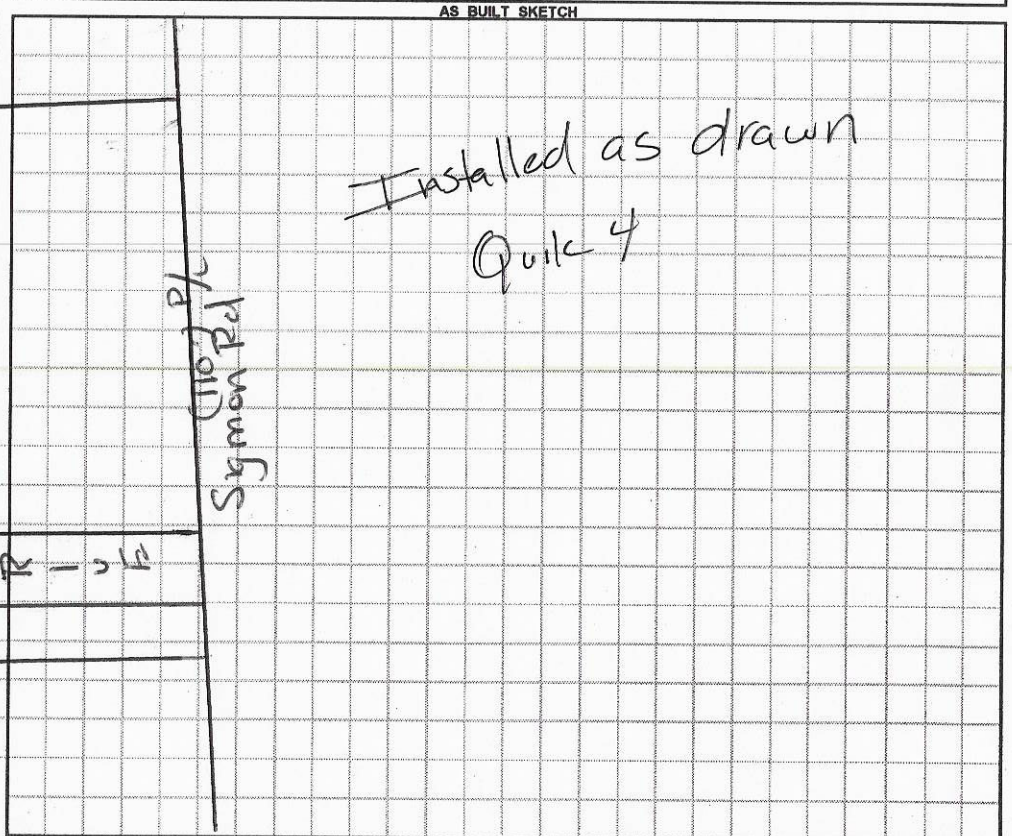

Permit can be suspended or revoked if any false information is supplied toward securing the permit / any unauthorized changes are made to the site / any unauthorized changes are made in the installation of the system. **CONTACT A LOCATOR SERVICE PRIOR TO ANY EXCAVATION**

☐ **IMPROVEMENT PERMIT** *with plat valid without expiration.* ☒ **IMPROVEMENT PERMIT** *with site plan valid for 60 mos.* ☒ **AUTHORIZATION TO CONSTRUCT** *valid for period equal to IMPROVEMENT PERMIT--not to exceed 60 mo.*

Owner / Applicant Signature: James Davidson Date: 4/14/14 Installed by: A-1 Backhoe

IMPROVEMENT PERMIT by: Robert T. Lowe Date: 04/11/14 OPERATION PERMIT by: Robert T. Lowe Date: 04/17/14

AUTHORIZATION TO CONSTRUCT by: Robert T. Lowe Date: 04/11/14 Existing System Inspected by: Date:

Health Dept. Copy - WHITE Applicant (Final Approval) - YELLOW Applicant (Conditional Approval) - PINK