IREDELL COUNTY HEALTH DEPARTMENT

Statesville Phone TR 3-7271 Mooresville Phone NO 3-1271

PERMIT TO INSTALL SEPTIC TANK

Permit No. 167 Permit Date Sept 26 1972

Owner Hope Bro Builders Address Statesville N.C.

Installed By Hope Bros " Address Statesville N.C.

Location of Property Lakeshore Acres


Lot # 206

Tank	Capacity	Length of Lines	Fixtures
Block ( )	1000 ( )	225' ( )	No. of Baths ( )
Precast (✓)	1250 ( )	250' (✓)	Dishwasher ( )
	1500 ( )	Other	Garbage Grdr. ( )
	Other		Other

NOTIFY HEALTH DEPARTMENT AT LEAST EIGHT HOURS BEFORE TANK IS TO BE INSPECTED.

Final Inspection Sept 29 1972 Approved (✓) Disapproved ( )

Remarks

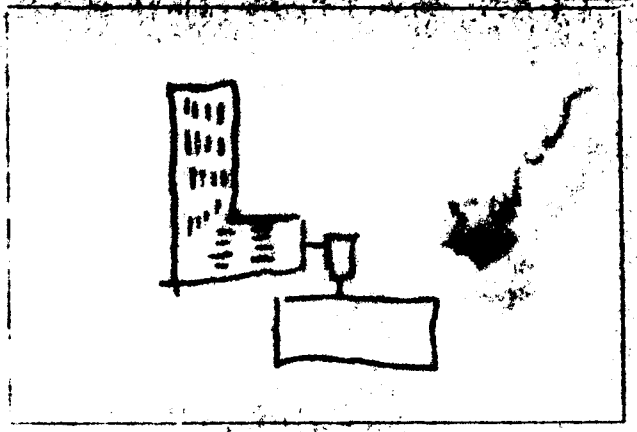

Sketch of Installation

R. M. Johnson R.S.

Sanitarian