IREDELL COUNTY HEALTH DEPARTMENT

Statesville Phone TR 3-7271 Mooresville Phone NO 3-12..

PERMIT TO INSTALL SEPTIC TANK

Permit No. 166 Permit Date 9-27 19 7?

Owner Hope Bre Builders Address Statesville N.C.

Installed By Same Address


Location of Property Out Salisbury Rd to Rd # 2354 - T.R. T.L. on Rd 2451 Back to left at 1st sharp curve 2nd house on R. Suburban Acres Lot # 202

Tank		Capacity		Length of Lines		Fixtures	
Block	( )	1000	(✓)	225'	(✓)	No. of Baths	(1½)
Precast	(✓)	1250	( )	250'	( )	Dishwasher	( )
		1500	( )	Other		Garbage Grdr.	( )
		Other				Other	

NOTIFY HEALTH DEPARTMENT AT LEAST EIGHT HOURS BEFORE TANK IS TO BE INSPECTED.

Final Inspection 9-27 19 7? Approved (✓) Disapproved ( )

Remarks Community Water

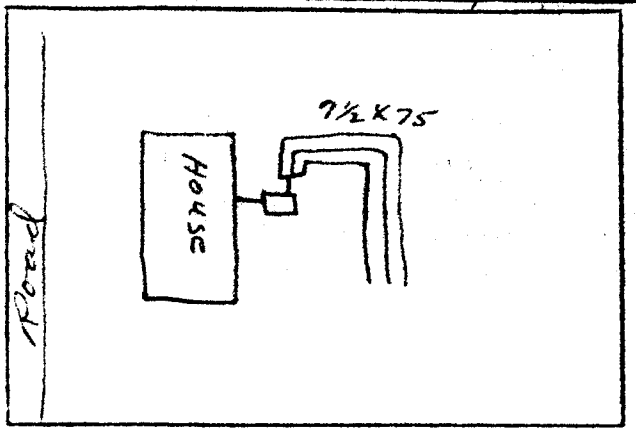

Sketch of Installation

E. A. Stevenson

Sanitarian