IREDELL COUNTY HEALTH DEPARTMENT

Statesville Phone TR 3-7271 Mooresville Phone No. 664-5281

PERMIT TO INSTALL SEPTIC TANK

Permit No. 3271 Permit Date 5-1 1973

Owner Larry England Address Statesville, NC

Installed By Hope Bros. Address Statesville, NC


Location of Property Boyburn Acres
Lot #57

Tank		Capacity		Length of Lines		Fixtures	
Block	( )	1000	( )	225'	( )	No. of Baths	( )
Precast	Repair	1250	( )	250'	( )	Dishwasher	( )
		1500	( )	Other 90		Garbage Grdr.	( )
		Other				Other	

NOTIFY HEALTH DEPARTMENT AT LEAST EIGHT HOURS BEFORE TANK IS TO BE INSPECTED.

Final Inspection 5-1 1973 Approved (✓) Disapproved ( )

Remarks

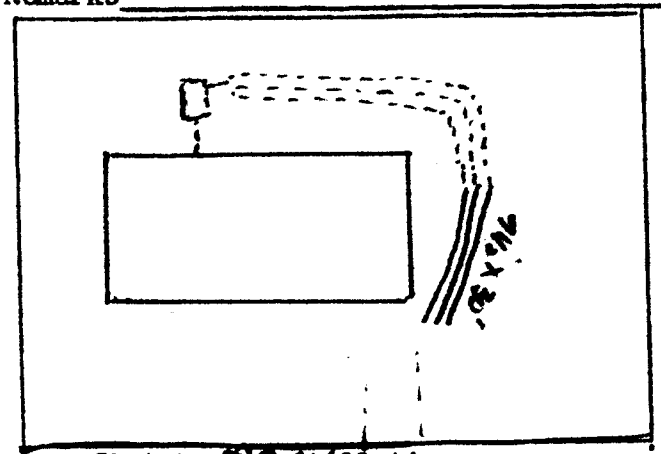

Sketch of Installation

Added Additional Line and repaired cement on inlet and outlet on Septic Tank - Also cemented Stub out at foundation

Glenn Todd

Sanitarian