IREDELL COUNTY HEALTH DEPARTMENT

Statesville Phone TR 3-7271 Mooresville Phone NO 3-1271

PERMIT TO INSTALL SEPTIC TANK

Permit No. 82 Bldr. Permit Date 8-21 1972

Owner Hope Bros Bldrs. Inc Address Statesville, N.C

Installed By Hope Bros Address Statesville, NC

Location of Property 70 E - Turn Right on Rd # 2355


Suburban Acres - Lot # 57

Tank		Capacity		Length of Lines		Fixtures	
Block	( )	1000	(✓)	225'	(✓)	No. of Baths	(14
Precast	(✓)	1250	( )	250'	( )	Dishwasher	( )
		1500	( )	Other		Garbage Grdr.	( )
		Other				Other	

NOTIFY HEALTH DEPARTMENT AT LEAST EIGHT HOURS BEFORE TANK IS TO BE INSPECTED.

Final Inspection 8-21 1972 Approved (✓) Disapproved ( )

Remarks Community WATER Supply

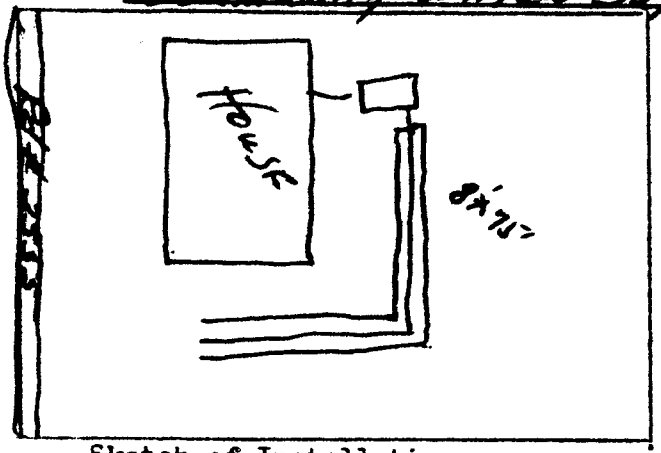

Sketch of Installation

Sanitarian