MARTIN WHITAKER

IREDELL COUNTY HEALTH DEPARTMENT - *ENVIRONMENTAL HEALTH* ✓ STATESVILLE OFFICE 704-878-5305 ☐ MOORESVILLE OFFICE 704-664-5281

IMPROVEMENT PERMIT / AUTHORIZATION TO CONSTRUCT / OPERATION PERMIT / EXISTING SYSTEM INSPECTION

PERMIT # REPAIR PIN # 4753-55-4552 ✓ DATE MARCH 8, 2012

OWNER JUANITA JEWELL KISER APPLICANT: SAME PHONE: Home/Cell # 704-202-7442 Business # 704-902-4602

✓ SITE ADDRESS 172 OAK GROVE ROAD - Statesville OWNER / APPLICANT ADDRESS 172 OAK GROVE ROAD, STATESVILLE, NC

SITE DIRECTIONS US 70 EAST, TR OAK GROVE ROAD, HOUSE ON RIGHT AT BOX #172

✓ SUBDIVISION SUBURBAN ACRES BLOCK / SECTION I LOT # 55 LOT AREA 0.535 ACRE DESIGN FLOW 240 L.T.A.R. 0.25GPD/FT²

Septic Tank EXISTING Gallons: STB ____ Date ____

Pump Tank 1000 Gallons: P T 283 Date 3-10-12

Pump Make ____ Model ____ Serial # ____

No. Nitrification Fields: 1 No. Lines 3 Linear Feet 150

Trench Width 24" Max. Trench Bottom Depth 32" Stone Gravel Depth 24"

~~New Construction~~ ☑ Repair ☐ Expansion System Type I II III IV V VI

System Description: CONVENTIONAL - BED

Repair System Description: 50% REDUCTION, PRESS MANIFOLD

Maintenance Agreement Required ☐ YES ☑ NO

☐ GRAVITY ☑ PRESSURE

☑ Residence No. Bedrooms 2

☐ Business No. Persons ____

☐ Other ____ No. Employees ____

☐ Slab ☐ Crawl Space


☑ Basement w/plumbing ☐ Basement w/o plumbing

Water Supply: ☑ Private WELL ☐ Public ☐ Community

Comments / Conditions ① INSTALL 50% REDUCTION SYSTEM USING 36 PGPFS PANELS ② KEEP SYSTEM MINIMUM 5' FROM PROPERTY LINE, 50' FROM WELL ③ SEE ATTACHED SHEETS FOR PUMP & P.M. REQUIREMENTS

MINIMUM SETBACK REQUIREMENTS TO SURFACE DIVERSION DITCHES CANNOT BE MET (BPJ)

INITIAL SITE SKETCH

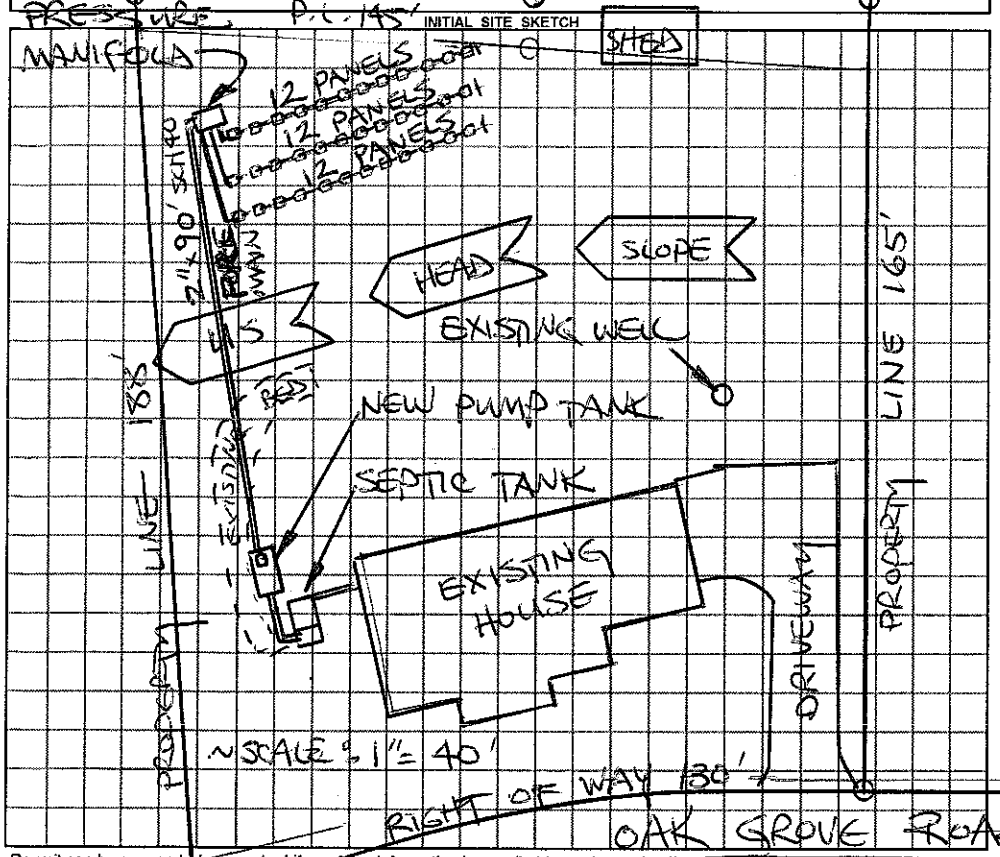

AS BUILT SKETCH

System Previously Inspected by R. Steve Hedrick

Permit can be suspended or revoked if any false information is supplied toward securing the permit / any unauthorized changes are made to the site / any unauthorized changes are made in the installation of the system.

☐ *IMPROVEMENT PERMIT* with plat valid without expiration. ☑ *IMPROVEMENT PERMIT* with plat valid without expiration. site plan valid 60 mo. ☑ *AUTHORIZATION TO CONSTRUCT* valid for period equal to IMPROVEMENT PERMIT--not to exceed 60 mo.

Owner / Applicant Signature: ____ Date 3-9-12 Installed by: James Hudler

IMPROVEMENT PERMIT by: R. STEVE HEDRICK REHS Date 3/8/2012 OPERATION PERMIT by: R. Steve Hedrick REHS Date 4/20/2012

AUTHORIZATION TO CONSTRUCT by: R. STEVE HEDRICK REHS Date 3/8/2012 Existing System Inspected by: ____ REHS Date ____

YOU SHOULD CONTACT A LOCATOR SERVICE PRIOR TO ANY EXCAVATION

White Copy – Environmental Health YELLOW COPY (Final) Owner / Applicant PINK COPY (Initial) Owner / Applicant