IREDELL COUNTY HEALTH DEPARTMENT

Statesville Phone TR 3-7271 — Mooresville Phone NO 3-1271

PERMIT TO INSTALL SEPTIC TANK

Permit NO. 245 — Permit Date July 28 1970

Owner Hope Bros. Builders — Address Statesville, NC.

Installed By Adams Septic Tank — Address Taylorsville, NC.


Location of Property Suburban Acres House #53

Tank		Capacity		Length of Lines		Fixtures	
Block	( )	1000	(✓)	225'	(✓)	No. of Baths	(1½
Precast	(✓)	1250	( )	250'	( )	Dishwasher	( )
		1500	( )	Other		Garbage Grdr.	( )
		Other				Other	

NOTIFY HEALTH DEPARTMENT AT LEAST EIGHT HOURS BEFORE TANK IS TO BE INSPECTED.

Final Inspection July 28 1970 — Approved (✓) Disapproved ( )

Remarks Community Well

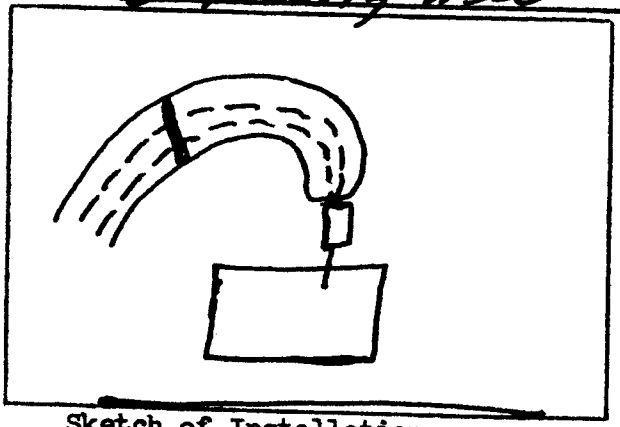

Sketch of Installation

Sanitarian