IREDELL COUNTY HEALTH DEPARTMENT

Statesville Phone TR 3-7271 Mooresville Phone NO 3-1271

PERMIT TO INSTALL SEPTIC TANK

Permit NO. 202 Permit Date JUNE 16 1970

Owner HOPE Bros Builders Inc Address STATESVILLE, N.C.

Installed By Adams Septic Tank Service Address TAYLORSVILLE, N.C.


Location of Property EAST ON Highway 70 - TURN RIGHT ON Road # 2355 - 1st HOUSE ON RIGHT IN SUBURBAN ACRES

Tank		Capacity		Length of Lines		Fixtures	
Block	( )	1000	(✓)	225'	(✓)	No. of Baths	(1½)
Precast	(✓)	1250	( )	250'	( )	Dishwasher	( )
		1500	( )	Other		Garbage Grdr.	( )
		Other				Other	

NOTIFY HEALTH DEPARTMENT AT LEAST EIGHT HOURS BEFORE TANK IS TO BE INSPECTED.

Final Inspection JUNE 16 1970 Approved (✓) Disapproved ( )

Remarks Community WELL. PERK TEST 30.

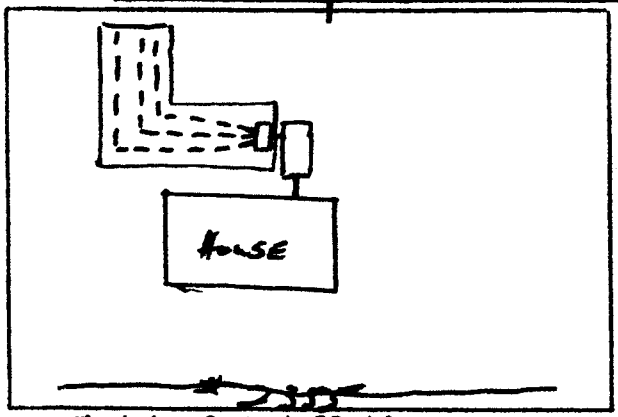

Sketch of Installation

Glenn Fields

Sanitarian