IREDELL COUNTY HEALTH DEPARTMENT

Statesville Phone TR 3-7271 Mooresville Phone MO 3-1271

PERMIT TO INSTALL SEPTIC TANK

Permit NO. _____ Permit Date Dec 15 1965

Owner George Mahaffey Address Statesville

Installed By Ray Smith Address Statesville


Location of Property Dakin Hasleburg Rd. Go N.E. 2m. 2335 to Right 5th House on Left

Tank		Capacity		Length of Lines		Fixtures	
Block	( )	800	( )	150'	( )	No. of Baths	( )
Precast	(✓)	900	( )	175'	( )	Dishwasher	( )
		1000	(✓)	200'	( )	Garbage Grdr.	( )
		1100	( )	225'	(✓)	Auto-Washer	( )
		1200	( )	250'	( )	Other	
		Other		Other			

NOTIFY HEALTH DEPARTMENT AT LEAST EIGHT HOURS BEFORE TANK IS TO BE INSPECTED.

Final Inspection _____ 19___ Approved ( ) Disapproved ( )

Remarks _____

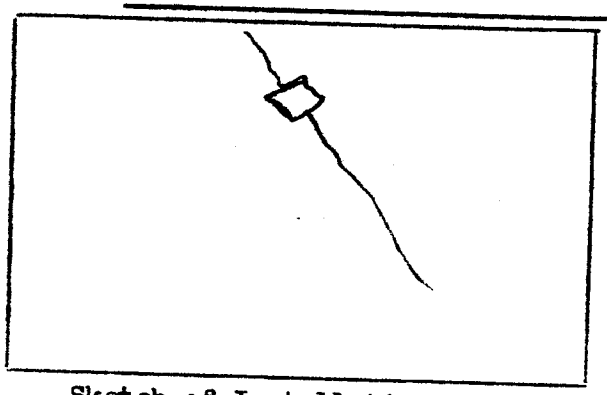

Sketch of Installation

County water

Sanitarian