IREDELL COUNTY HEALTH DEPARTMENT

L-173

STATESVILLE 704-878-5305 MOORESVILLE 704-664-5281

IMPROVEMENT PERMIT / AUTHORIZATION TO CONSTRUCT / OPERATION PERMIT / EXISTING SYSTEM INSPECTION

PERMIT# REPAIR PIN# 4753-56-7279 AND 4753-56-7377 L-170 DATE 07/03/06

OWNER OR APPLICANT DENNIS GILLESPIE AND RICARDO URREA PHONE: Business 704-880-7765 Home 704-872-1984

ADDRESS 135 OAK GROVE RD. STATESVILLE, NC (AND) 129 OAK GROVE RD. STATESVILLE, NC

LOCATION HWY 70 EAST FROM STVL., (R) OAK GROVE RD., ON LEFT JUST BEFORE SIGMON RD. @ BOX # 135 AND #129.

SUBDIVISION Suburban Acr BLOCK / SECTION ____ LOT 13-17 LOT AREA 0.26 AC. AND 0.26 SITE CLASS. REPAIR DESIGN FLOW 720 GPD L.T.A.R. 0.20 GPD/FT²

EXIST. Septic Tank: ? Gallons; STB ____ Date ____

Pump Tank: ____ Gallons; PT ____ Date ____

Pump Make: ____ Model ____ Serial No. ____

Nitrification Field: No Fields 1 Square Feet 1470 Linear Feet 490'

No Lines 6 Trench Width 36" Trench Bottom Depth 36"

☐ New System ☒ Repair ☐ Expansion System Type: I (II) III IV V VI

~~System Description:~~

Repair System Description: CONVENTIONAL, GRAVITY

Maintenance Agreement Required: ☐ Yes ☒ No

Gravel Depth 18" ☒ Gravity ☐ Pressure ☐ Slab ☒ Crawl Space ☐ Basement w/plumbing ☐ Basement wo/plumbing

☒ House/Mod. Home (2) No. Bedrooms 6

☐ Mobile Home No. Persons ____

☐ Business No. Employees ____

☐ Other ____

Water Supply: SHARED

☒ Individual WELL

☐ Public


☐ Community

Comments:/Conditions: (1) INSTALL TRENCHES AT 36" DEPTH. (2) START TRENCHES AT 36" DEEP. (3) USE 18" GRAVEL DEPTH. (4) AN EXISTING EASEMENT WAS CREATED FOR THE WASTEWATER SYSTEM WHEN HOMEOWNER PURCHASED HOME.

Comments:/Conditions:

THIS PERMIT SERVES AS "NOTICE OF VIOLATION" AND THE SYSTEM MUST BE CORRECTED WITHIN 30 DAYS.

INITIAL SITE SKETCH

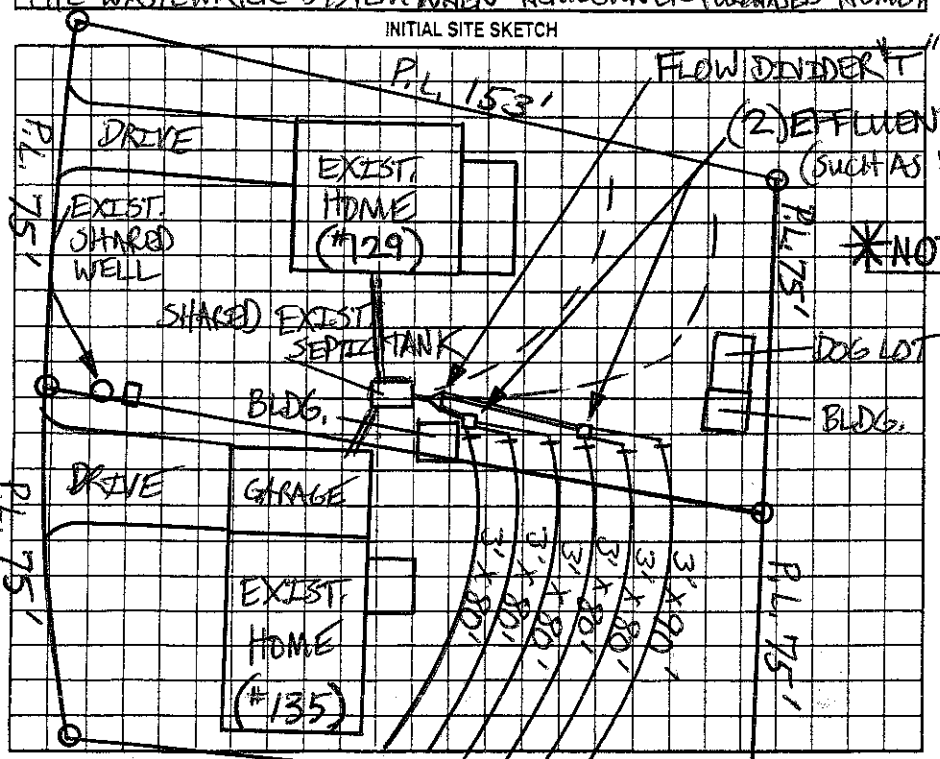

AS BUILT SKETCH

*NOT TO SCALE

*INSTALLED AS SHOWN.

Permit can be suspended or revoked if any false information is supplied toward securing the permit/any unauthorized changes are made to the site/any unauthorized changes are made in the installation of the system. Improvement Permit with plat valid for one year ☐ Improvement Permit with site plan valid for sixty months ☒ Authorization to Construct is valid for a period equal to that of Improvement Permit – not to exceed sixty months.

Signed: ____ date 7/17/06

Improvement Permit by: ____ date 07/03/06

Authorization to Construct by: ____ date 07/03/06

Installed by: A-1 BACKHOE 8-28-06, 08/29/06

Operation Permit by: ____ date 08/29/06

Existing System Inspection by: ____ date ____

HEALTH DEPT. COPY: WHITE OWNER COPY (FINAL): YELLOW OWNER COPY (INITIAL): PINK