IREDELL COUNTY HEALTH DEPARTMENT - *ENVIRONMENTAL HEALTH* ☒ STATESVILLE OFFICE 704-878-5305 ☐ MOORESVILLE OFFICE ~~704-664-5281~~

IMPROVEMENT PERMIT / AUTHORIZATION TO CONSTRUCT / OPERATION PERMIT / EXISTING SYSTEM INSPECTION

PERMIT # Lapsed PIN # ~~4753-56-9375~~ 9470 DATE 3-18-11

OWNER Rhonda Thompson APPLICANT: PHONE: Home/Cell # 704 928 8422 Business #

SITE ADDRESS 134 Dellwood OWNER / APPLICANT ADDRESS 134 Dellwood

SITE DIRECTIONS 70 West, Road on right past Oak Grove, turn (R) on (R)


SUBDIVISION N/A BLOCK / SECTION n/a LOT # n/a LOT AREA 2 lots DESIGN FLOW 480 L.T.A.R. .25

Septic Tank 1000	Gallons: STB 760	Date 5-10-10	☒ New System	☐ Repair	☐ Expansion System	Type I II (III) IV V VI	☒ Residence	No. Bedrooms 4	Water Supply
Pump Tank 1000	Gallons: PT 363	Date 6-16-10	~~System Description:~~ Pump (25% Reduction)				☐ Business	No. Persons	☒ Private
Pump Make Goulds	Model WE0712H	Serial #	Repair System Description:				☐ Other	No. Employees	☐ Public
No. Nitrification Fields: 1	No. Lines 10	Linear Feet 480	Maintenance Agreement Required ☐ YES ☒ NO				☐ Slab	☐ Crawl Space	☐ Community
Trench Width 36"	Max. Trench Bottom Depth 36"		Gravel Depth n/a	☐ GRAVITY	☒ PRESSURE		☐ Basement w/plumbing	☒ Basement w/o plumbing	

Comments / Conditions

1" = 60'

INITIAL SITE SKETCH

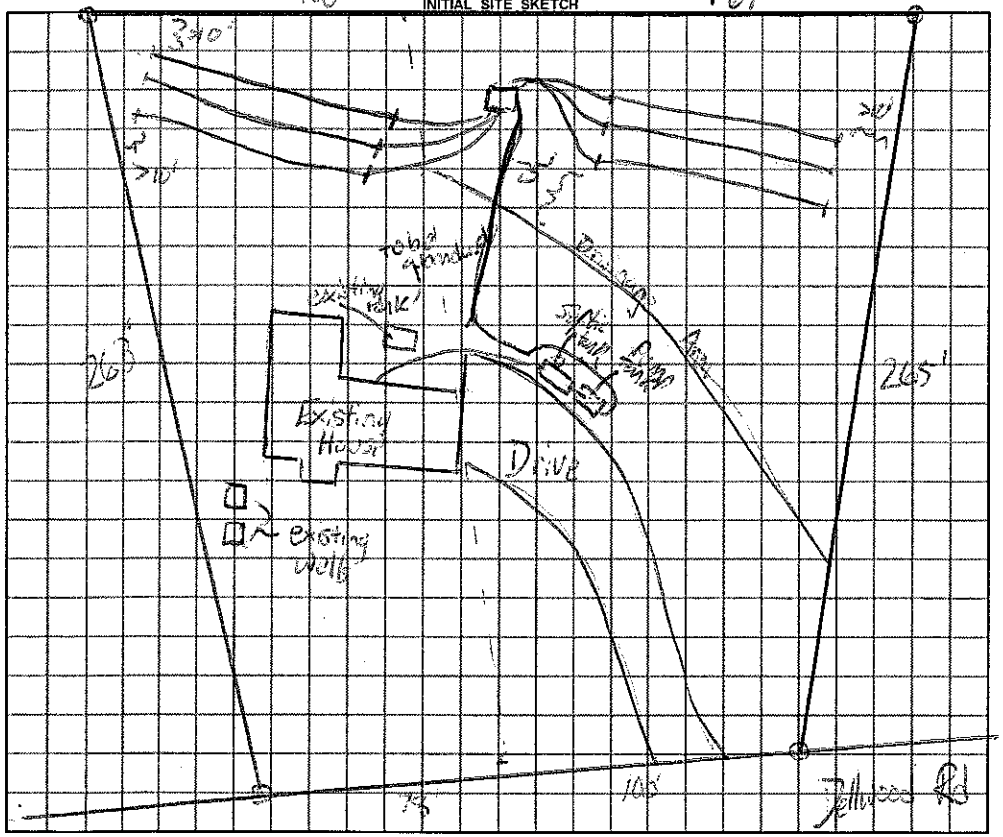

GOULDS PUMPS

WE0712H

SUBMERSIBLE PUMP

3/4HP 1/60/230 4.06" 10.0MA

ITT

	Date	Initials
Drain Lines Checked	4-13-11	TCH
Tanks Checked	4-13-11	TCH
Pressure Manifold or Valve Box Checked	4-13-11	TCH
Pressure Head Set	09/14/15	HS
Electrical Checked	09/14/15	HS
Floats Set	09/14/15	HS
Alarm Checked	09/14/15	HS
Maintenance Contract Y / N	N	

Permit can be suspended or revoked if any false information is supplied toward securing the permit / any unauthorized changes are made to the site / any unauthorized changes are made in the installation of the system.

☐ ***IMPROVEMENT PERMIT*** with plat valid without expiration. ☒ ***IMPROVEMENT PERMIT*** with ~~plat valid without expiration.~~ site plan valid 60 mo. ☒ ***AUTHORIZATION TO CONSTRUCT*** valid for period equal to IMPROVEMENT PERMIT--not to exceed 60 mo.

Owner / Applicant Signature: Rhonda Thompson Date 3-21-11 Installed by: A-1 Backhoe

IMPROVEMENT PERMIT by: James Stewart REHS Date 3-18-11 OPERATION PERMIT by: Finaled James Stewart REHS Date 4-13-11

AUTHORIZATION TO CONSTRUCT by: James Stewart REHS Date 3-18-11 Existing System Inspected by: REHS Date

YOU SHOULD CONTACT A LOCATOR SERVICE PRIOR TO ANY EXCAVATION

White Copy – Environmental Health YELLOW COPY (Final) Owner / Applicant PINK COPY (Initial) Owner / Applicant