IREDELL COUNTY HEALTH DEPARTMENT

Statesville Phone TR 3-7271 Mooresville Phone NO 3-1271

PERMIT TO INSTALL SEPTIC TANK

Permit No. 192 Permit Date 7-18 1972

Bldr.

Owner Hoke Biles Address Statesville, NC

Installed By Herman Gibson Address Statesville, NC


Location of Property Highway 70 E. Turn Right on Rd # 2318. Go 1 1/4 mile to new development on Rt. Lot #3

Tank		Capacity		Length of Lines		Fixtures	
Block	( )	1000	(✓)	225'	(✓)	No. of Baths	(1½)
Precast	(✓)	1250	( )	250'	( )	Dishwasher	( )
		1500	( )	Other		Garbage Grdr.	( )
		Other				Other	

NOTIFY HEALTH DEPARTMENT AT LEAST EIGHT HOURS BEFORE TANK IS TO BE INSPECTED.

Final Inspection 7-18 1972 Approved (✓) Disapproved ( )

Remarks Community Water System

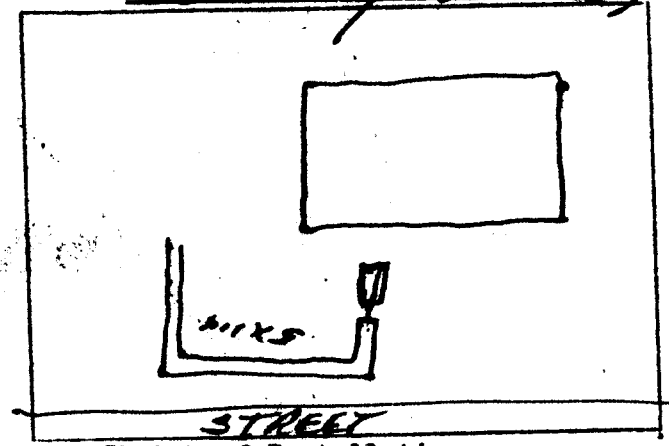

Sketch of Installation

Glenn Tate

Sanitarian