IREDELL COUNTY HEALTH DEPARTMENT

STATESVILLE 704-878-5305 MOORESVILLE 704-664-5281

IMPROVEMENT PERMIT / AUTHORIZATION TO CONSTRUCT / OPERATION PERMIT / EXISTING SYSTEM INSPECTION

PERMIT # 136943 PIN # 4753-61-7182 DATE 7-10-09

OWNER or APPLICANT Ronald Reid PHONE: Business Home: 704-450-2870

OWNER or APPLICANT ADDRESS 133 Homestead Estates Drive Statesville

LOCATION / DIRECTIONS 70 E (R) Shiloh (R) Homestead 2nd on left

SUBDIVISION Homestead Estates BLOCK / SECTION LOT # 19 LOT AREA DESIGN FLOW 360 L.T.A.R. Evst

Septic Tank Existing Gallons: STB Evst Date Evst

Pump Tank Gallons: P T Date

Pump Make Model Serial #

Nitrification Field No Fields No Lines Linear Feet

Trench Width Evst Max. Trench Bottom Depth Evst Gravel Depth Evst

~~New System~~ Existing ☐ Repair ☐ Expansion System Type I II III IV V VI

System Description: Conventional Gravity

Repair System Description: 2590 Gravity

Maintenance Agreement Required ☐ YES ☒ NO

☐ GRAVITY ☐ PRESSURE

☒ Residence No. Bedrooms 3

☐ Business No. Persons

☐ Other No. Employees

☐ Slab ☐ Crawl Space

☐ Basement w/plumbing ☐ Basement w/o plumbing

Water Supply

☑ Private

☐ Public


☐ Community

Comments / Conditions	Comments / Conditions

INITIAL SITE SKETCH

Building does not encroach on septic system. Right of R.S.

AS BUILT SKETCH

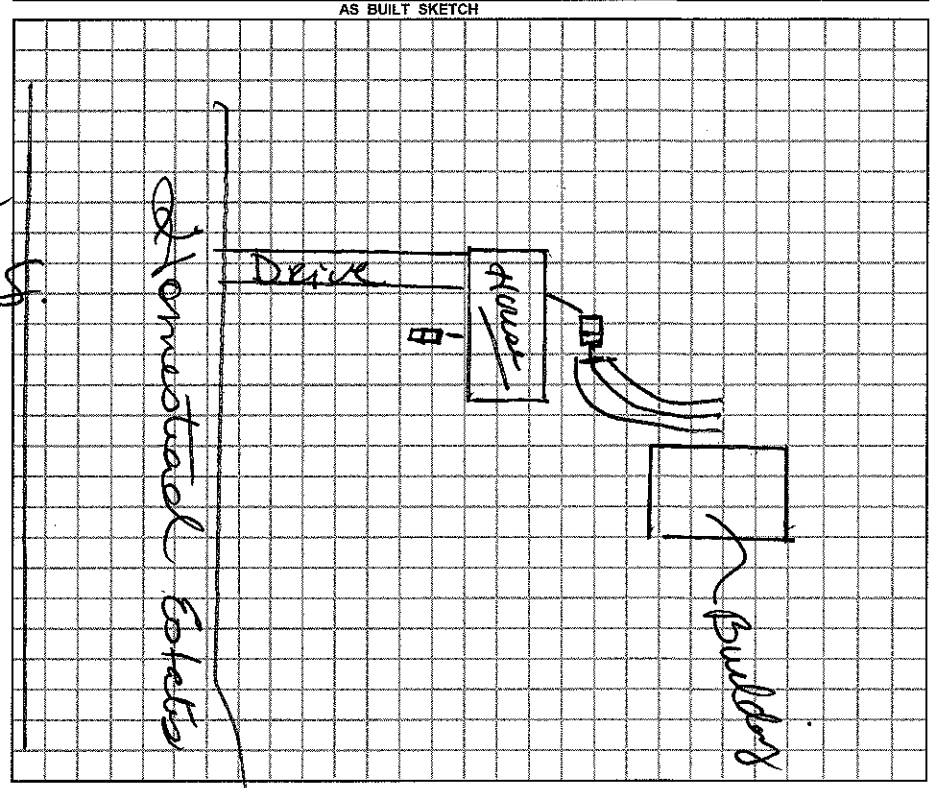

Permit can be suspended or revoked if any false information is supplied toward securing the permit / any unauthorized changes are made to the site / any unauthorized changes are made in the installation of the system.

☐ *IMPROVEMENT PERMIT w / plat valid without expiration.* ☐ *IMPROVEMENT PERMIT w / site plan valid for 60 mos.* ☐ *AUTHORIZATION TO CONSTRUCT valid for period equal to IMPROVEMENT PERMIT-not to exceed 60 mo.*

Owner / Applicant Signature: Date

Improvement Permit by: Date

Authorization to Construct by: Date

YOU SHOULD CONTACT A LOCATOR SERVICE PRIOR TO ANY EXCAVATION.

Installed by:

Operation Permit by: Date:

Existing System Inspected by: Date: 6-12-09

WHITE COPY Environmental Health YELLOW COPY (Final) Owner / Applicant PINK COPY (Initial) Owner / Applicant