CT

IREDELL COUNTY HEALTH DEPARTMENT

STATESVILLE 704-878-5305 MOORESVILLE 704-664-5281

IMPROVEMENT PERMIT / AUTHORIZATION TO CONSTRUCT / OPERATION PERMIT / EXISTING SYSTEM INSPECTION

PERMIT# 133681 PIN# 4753630 630

OWNER OR APPLICANT Juan Nunez DATE 3-17-06

ADDRESS 164 Oak Grove Statesville NC 28625 PHONE: Business ______ Home 704-682-1412

LOCATION 77 S Exit 49 (R) → (R) Sigmon Dr (L) Diane Lane at end on left

SUBDIVISION Suburban Acr BLOCK / SECTION II LOT 8 LOT AREA ______ SITE CLASS. PS DESIGN FLOW 360 L.T.A.R. .2

Septic Tank: 1000 Gallons; STB 100 Date 1-30-06

Pump Tank: ______ Gallons; PT ______ Date ______

Pump Make: ______ Model ______ Serial No. ______

Nitrification Field: No Fields ______ Square Feet 1800 Linear Feet 480

No Lines 7 Trench Width 36" Max Trench Bottom Depth 24" max Gravel Depth ______

☑ New System ☐ Repair ☐ Expansion System Type: I II **III** IV V VI

System Description: 25% Gravity

Repair System Description: LP 25% .25 GPM

Maintenance Agreement Required: ☐ Yes ☐ No

☑ Gravity ☐ Pressure

☐ House/Mod. Home ☑ Mobile Home ☐ Business ☐ Other ______

No. Bedrooms 3 No. Persons ______ No. Employees ______


Water Supply: ☑ Individual ☐ Public ☐ Community

☐ Slab ☑ Crawl Space ☐ Basement w/plumbing ☐ Basement wo/plumbing

Comments/Conditions: NO GRADING - or Septic permit will be voided!

Comments/Conditions: (1) Mobile Home is 165' from property line - LAst Septic Line is to be NO more than 145' from property line

INITIAL SITE SKETCH

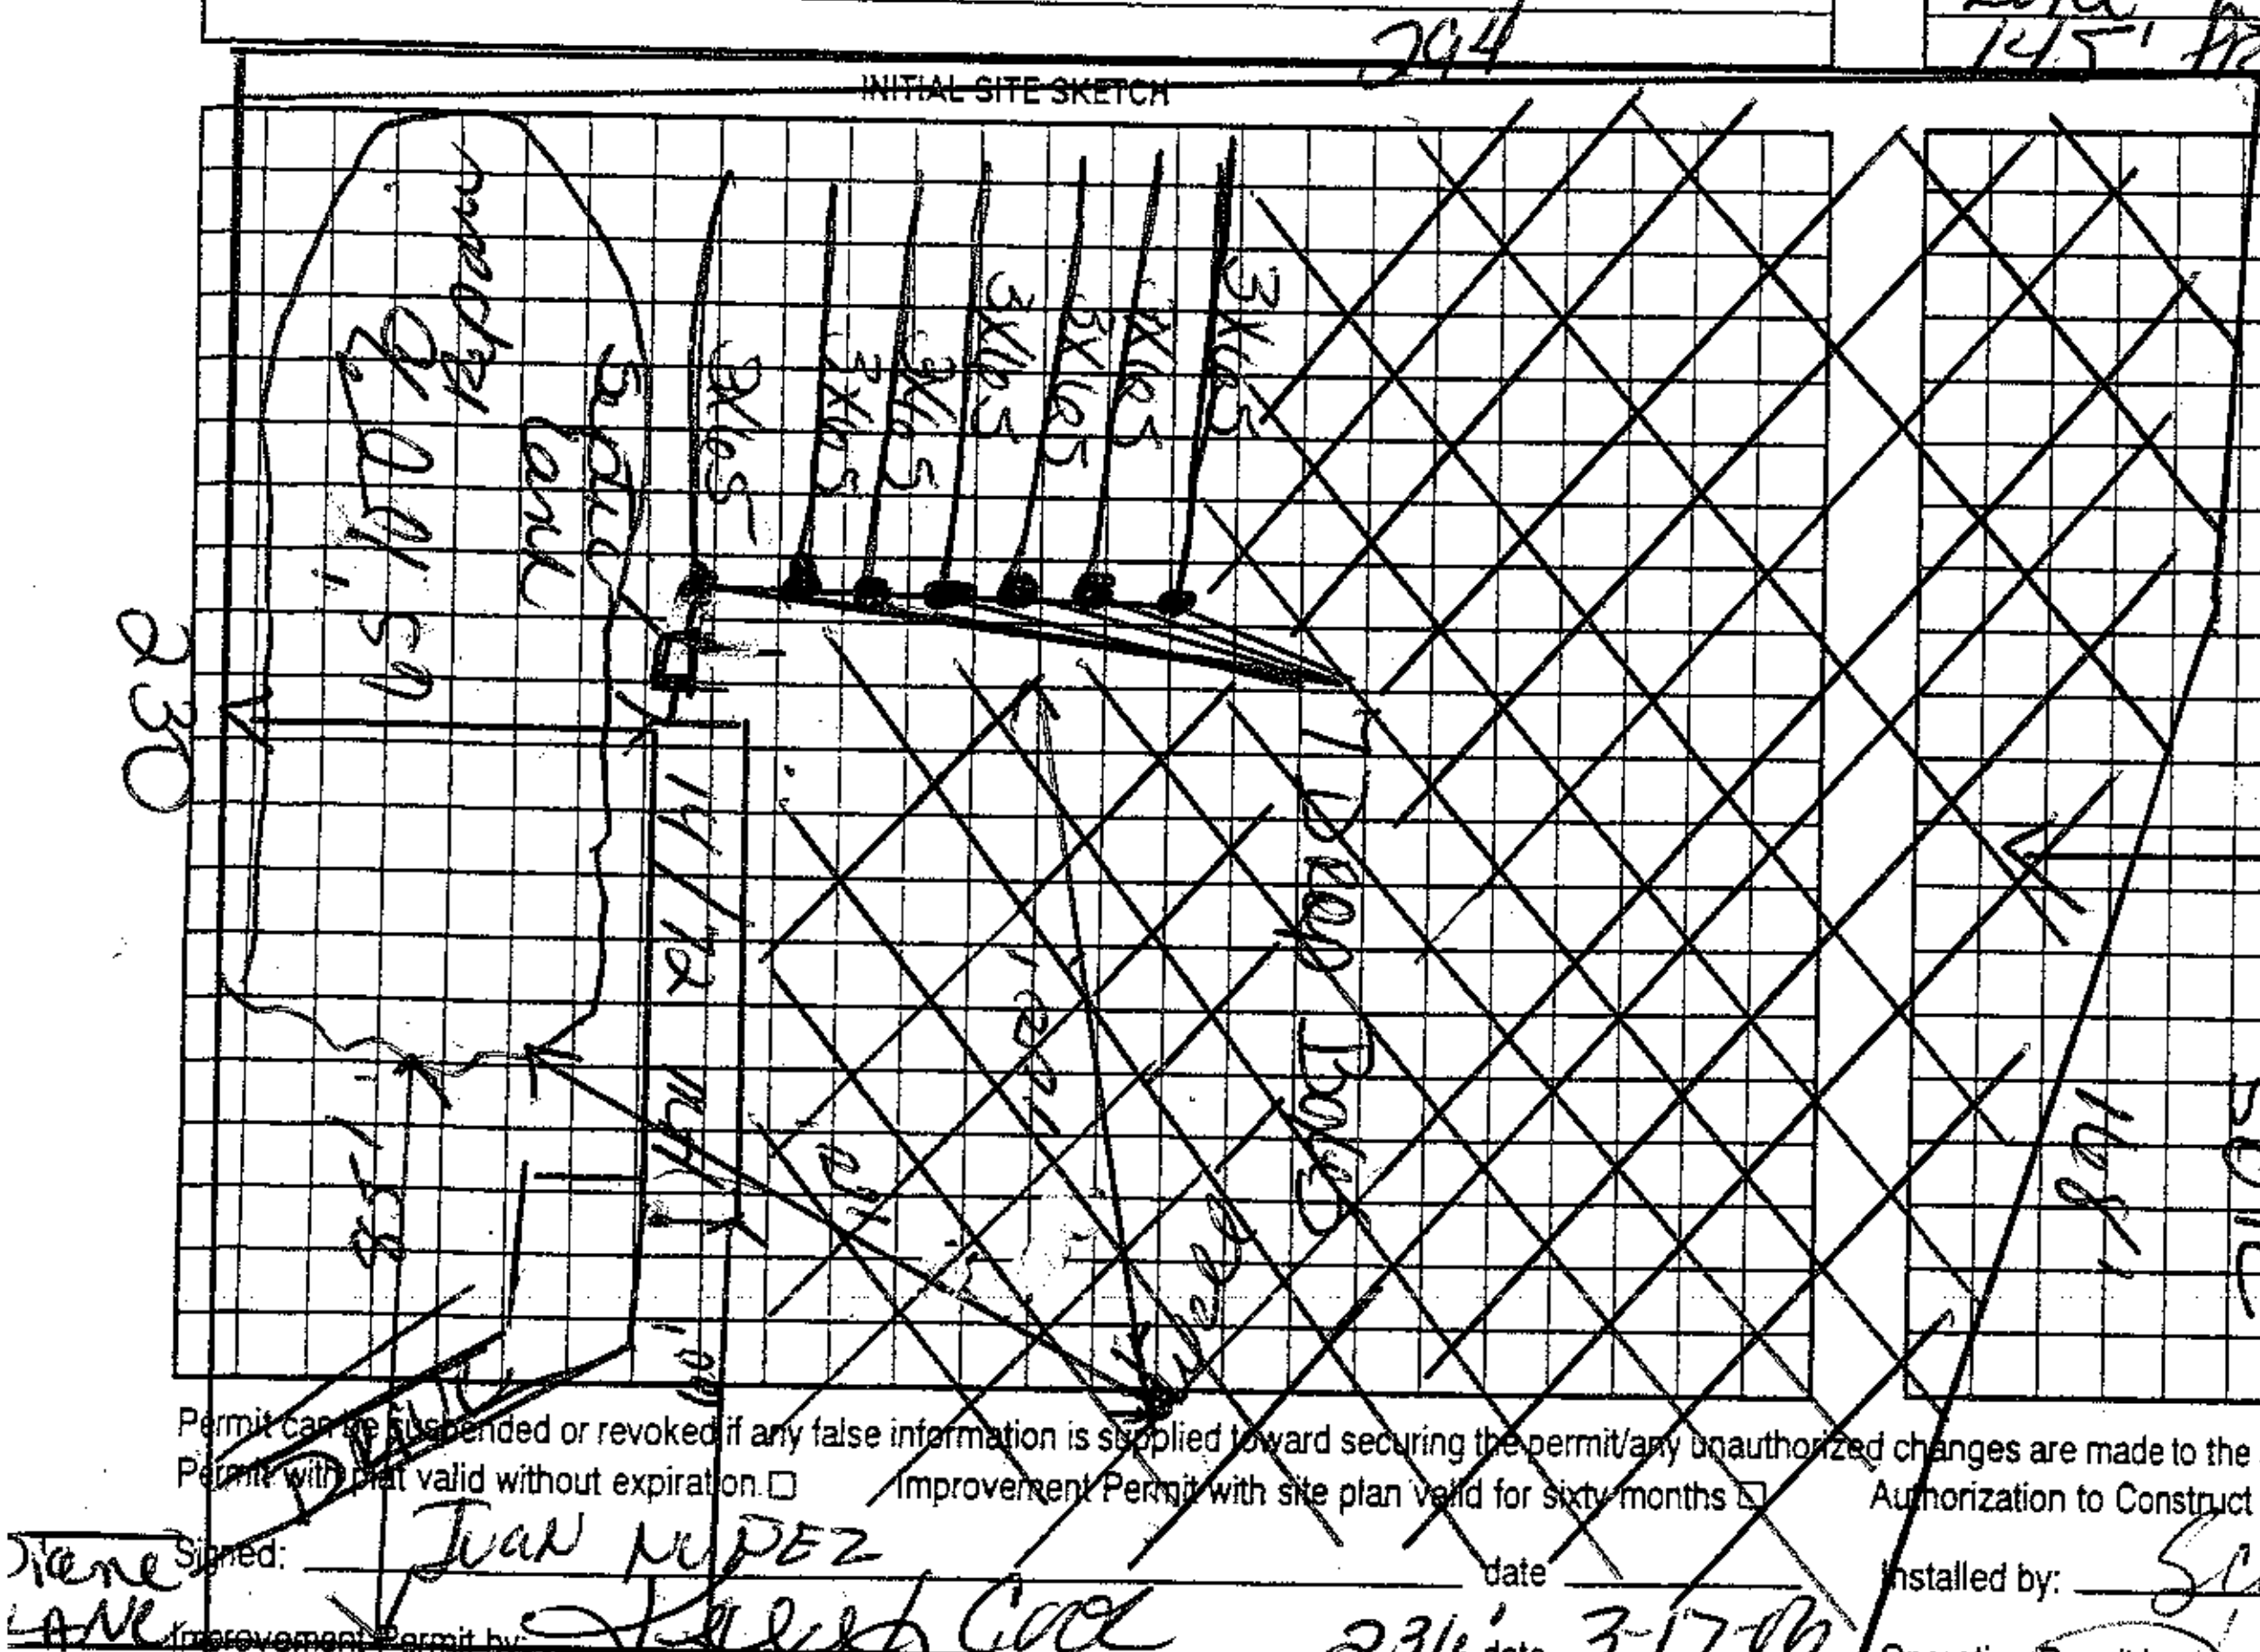

AS BUILT SKETCH

(2) Well must be 100' away from septic - initial and Repair

(3) 24" Trench Bottom

(4) Absolutely No grading! Permit will be voided!

(5) maintain all setbacks

(6) Installation contour

Red Septic Filter Polylock

Septic tank marker

Permit can be suspended or revoked if any false information is supplied toward securing the permit/any unauthorized changes are made to the site/any unauthorized changes are made in the installation of the system. Improvement Permit with plat valid without expiration ☐ Improvement Permit with site plan valid for sixty months ☐ Authorization to Construct is valid for a period equal to that of Improvement Permit – not to exceed sixty months.

Signed: Juan Nunez date ______

Improvement Permit by: Kelly Cook date 3-17-06

Authorization to Construct by: Kelly Cook date 3-17-06

Installed by: Scott Carper

Operation Permit by: Kelly Cook date 4-6-06

Existing System Inspection by: ______ date ______

HEALTH DEPT. COPY: WHITE OWNER COPY (FINAL): YELLOW OWNER COPY (INITIAL): PINK