IREDELL COUNTY HEALTH DEPARTMENT

Statesville Office (704) 878-5305 Mooresville Office (704) 660-3625 PERMIT # 21,5112

IMPROVEMENT PERMIT / AUTHORIZATION TO CONSTRUCT / OPERATION PERMIT / EXISTING SYSTEM

PIN # 4753-66-0721

APPLICANT: Venture Properties VII LLC/Dollar General APPLICANT ADDRESS: 126 Executive Dr, Suite 200, Wilkesboro NC 28697

SITE ADDRESS: 2046 Salisbury Hwy PHONE: 336-667-8000 ALT. PHONE:

SITE DIRECTIONS: Hwy 70/Salisbury Hwy East, L Loton R after Oak Grove Rd

SUBDIVISION: Dellwood SECTION: LOT # 8-12 LOT AREA: 2.56ac DESIGN FLOW: 200gpd L.T.A.R.: 0.25

Septic Tank	1000	(gal)	STB	760	Date	12-14-15	☑ New System ☐ Repair ☐ Expansion	System Type: I II (III) IV V VI	
Pump Tank	N/A	(gal)	PT	N/A	Date	N/A	System Description:	Gravity 25% Reduction	
Pump Make	N/A	Model		Poly Tek	Serial #	PL-65	Repair System Description:	Gravity 25% Reduction	
# Nitrification Fields	1	# Lines		12	Linear Ft:	200'	Maintenance Agreement Required:	☐ YES ☑ NO	
Trench Width	36"	Max. Trench Bottom Depth		*26" *	Gravel Depth	N/A	☑ GRAVITY	☐ PRESSURE	

☐ Residence ☑ Business ☐ Other ☑ Slab ☐ Basement w/plumbing


No. Bedrooms: No. Persons: 8 No. Employees: ☐ Crawl Space

☐ Basement w/o plumbing

Water Supply: ☐ Private ☑ Public ☐ Community

Comments / Conditions:

INITIAL SITE SKETCH

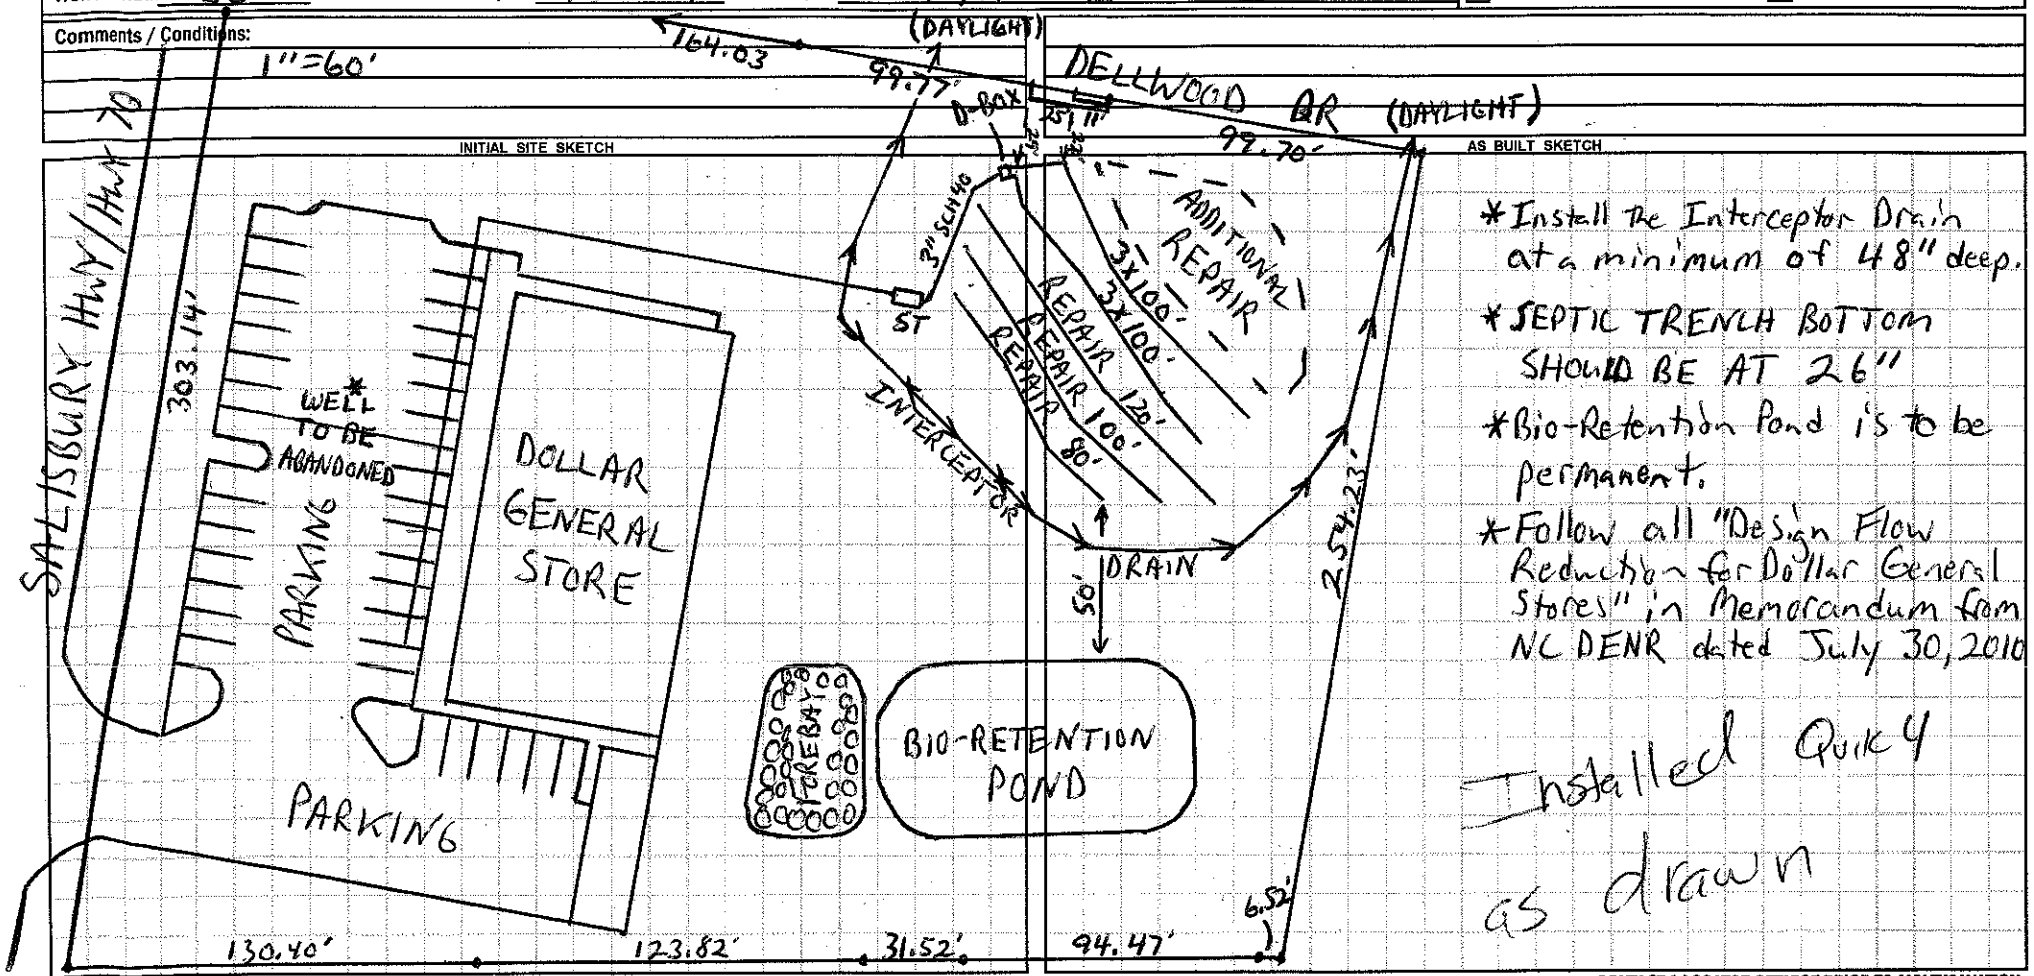

AS BUILT SKETCH

*Install the Interceptor Drain at a minimum of 48" deep.

*SEPTIC TRENCH BOTTOM SHOULD BE AT 26"

*Bio-Retention Pond is to be permanent.

*Follow all "Design Flow Reduction for Dollar General Stores" in Memorandum from NC DENR dated July 30, 2010

Installed Quick 4 as drawn

Permit can be suspended or revoked if any false information is supplied toward securing the permit / any unauthorized changes are made to the site / any unauthorized changes are made in the installation of the system. **CONTACT A LOCATOR SERVICE PRIOR TO ANY EXCAVATION**

☐ **IMPROVEMENT PERMIT** *with plat valid without expiration.* ☑ **IMPROVEMENT PERMIT** *with site plan valid for 60 mos.* ☐ **AUTHORIZATION TO CONSTRUCT** *valid for period equal to IMPROVEMENT PERMIT--not to exceed 60 mo.*

Owner / Applicant Signature: Date: 1-27-16 Installed by: B+S Septic

IMPROVEMENT PERMIT by: Date: 1-25-16 OPERATION PERMIT by: Date: 03/18/16

AUTHORIZATION TO CONSTRUCT by: Date: 1-27-16 Existing System Inspected by: Date:

Health Dept. Copy - WHITE Applicant (Final Approval) - YELLOW Applicant (Conditional Approval) - PINK