IREDELL COUNTY HEALTH DEPARTMENT

Statesville Phone TR 3-7271 Mooresville Phone NO 3-1271

PERMIT TO INSTALL SEPTIC TANK

Permit No. Roscoe Warren Alder Permit Date Nov 4 1966

Owner F.A. Fox - Lillian Fox Address Salisbury Rt.

Installed By C Hyke Address R7


Location of Property Dellinger S/D on R. past St. Paul Church - S Salisbury Rd.

Tank		Capacity		Length of Lines		Fixtures	
Block	( )	1000	( )	225'	( )	No. of Baths	(2)
Precast	(✓)	1250	( )	250'	( )	Dishwasher	(✓)
		1500	( )	Other 240'		Garbage Grdr.	( )
		Other				Other	

NOTIFY HEALTH DEPARTMENT AT LEAST EIGHT HOURS BEFORE TANK IS TO BE INSPECTED.

Final Inspection _____ 19__ Approved ( ) Disapproved ( )

Remarks well 75' - Not to be held liable for any damage that may accouse from concrete truck crossing line, as owner refused to grade or pour basement before hand

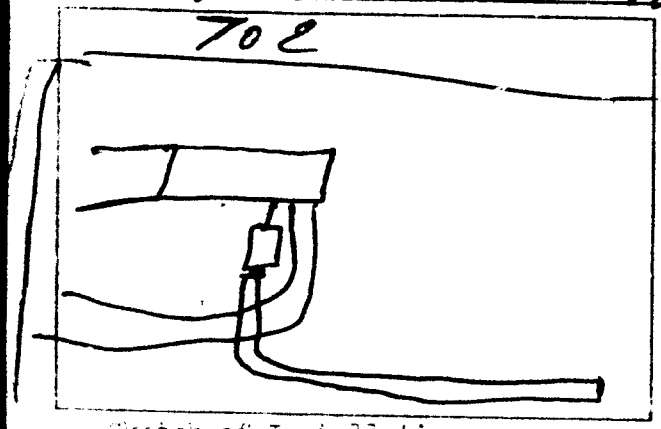

Sketch of Installation

Sanitarian