264

IREDELL COUNTY HEALTH DEPARTMENT

Statesville Phone TR 3-7271 Mooresville Phone NO 3-1271

PERMIT TO INSTALL SEPTIC TANK

Permit NO. Gilbert Engr. & Contractor Permit Date Feb 21 1968

Owner Signal Mnt. Cement Co. Address R7

Installed By C Stoke Address R7


Location of Property Salisbury Rd on left past St. Paul Ch. - 2 cement bins -

Tank		Capacity		Length of Lines		Fixtures	
Block	( )	1000	( )	225'	( )	No. of Baths	( )
Precast	(✓)	1250	(✓)	250'	(✓)	Dishwasher	( )
Lock Joint		1500	( )	Other		Garbage Grdr.	( )
		Other				Other Office	

NOTIFY HEALTH DEPARTMENT AT LEAST EIGHT HOURS BEFORE TANK IS TO BE INSPECTED.

Final Inspection 19 Approved ( ) Disapproved ( )

Remarks Well 100' - Deep - filled dirt

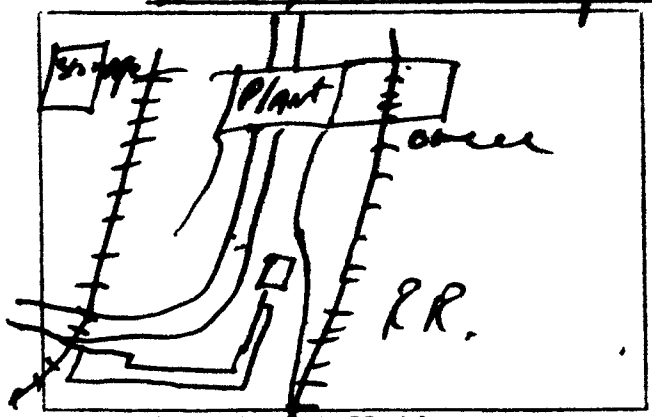

Sketch of Installation

Sanitarian