IREDELL COUNTY HEALTH DEPARTMENT

Statesville Phone TR 3-7271 Mooresville Phone NO 3-1271

PERMIT TO INSTALL SEPTIC TANK

Permit No. _____ Permit Date Aug 16 1966

Owner T. P. Putman Address R7

Installed By C Hoke Addr ss R7


Location of Property last house on R beyond 3rd creek on Shiloh Ch. Rd.

Tank		Capacity		Length of Lines		Fixtures	
Block	( )	1000	(→)	225'	(→)	No. of Baths	(1)
Precast	(→)	1250	( )	250'	( )	Dishwasher	( )
		1500	( )	Other _____		Garbage Grdr.	( )
		Other _____				Other _____	

NOTIFY HEALTH DEPARTMENT AT LEAST EIGHT HOURS BEFORE TANK IS TO BE INSPECTED.

Final Inspection _____ 19___ Approved ( ) Disapproved ( )

Remarks well 50'

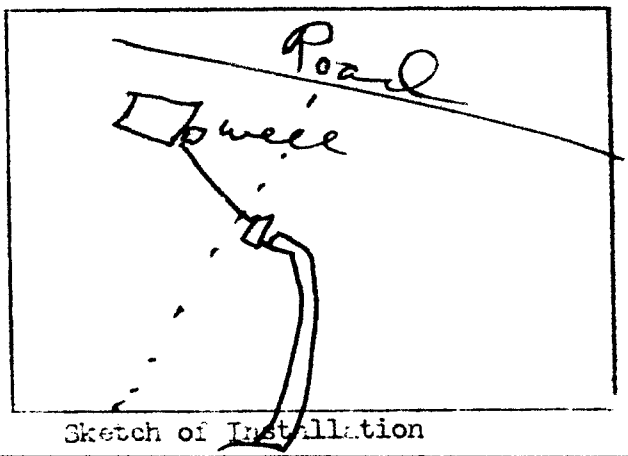

Sketch of Installation

Sanitarian