IREDELL COUNTY HEALTH DEPARTMENT

STATESVILLE 704-878-5305 MOORESVILLE 704-664-5281

IMPROVEMENT PERMIT / AUTHORIZATION TO CONSTRUCT / OPERATION PERMIT / EXISTING SYSTEM INSPECTION

PERMIT# Repair PIN# DATE 1-6-98

OWNER OR CONTRACTOR R.V. Fox PHONE: Business Home

ADDRESS 320 Shiloh ch Rd Statesville

LOCATION 70 E TR Shiloh 1/4 mi left.

SUBDIVISION BLOCK / SECTION LOT LOT AREA acres SITE CLASS. PS DESIGN FLOW 420 L.T.A.R. .28

Septic Tank: EX 1000 Gallons; STB Date

Pump Tank: 1000 Gallons; PT 188 Date

Pump Make: Hydromatic Model SHEF 50A-1 Serial No.

Nitrification Field: No Fields 1 Square Feet 1800 Linear Feet 600

No Lines 4 Trench Width 36" Max Trench Bottom Depth 24" Gravel Depth 12"

☑ New System ☒ Repair System Type: I, II, III, IV, V, VI

System Description:

Repair System Description: Pump to Const.

Maintenance Agreement Required: ☐ Yes ☑ No

☑ House/Mod. Home No. Bedrooms 3

☐ Mobile Home No. Bathrooms

☐ Business No. Employees

☐ Other 4 People in home


☐ Slab ☐ Crawl Space ☐ Basement w/plumbing ☐ Basement w/o plumbing

Water Supply: ☑ Individual ☐ Public ☐ Community

Comments/Conditions: See Attached Sheets for P.T. & Pump Drawings which become Part of this Permit

Comments/Conditions: Checked lines, electrical tank 35-99 Need pressure check & NEMA 4 Box

INITIAL SITE SKETCH

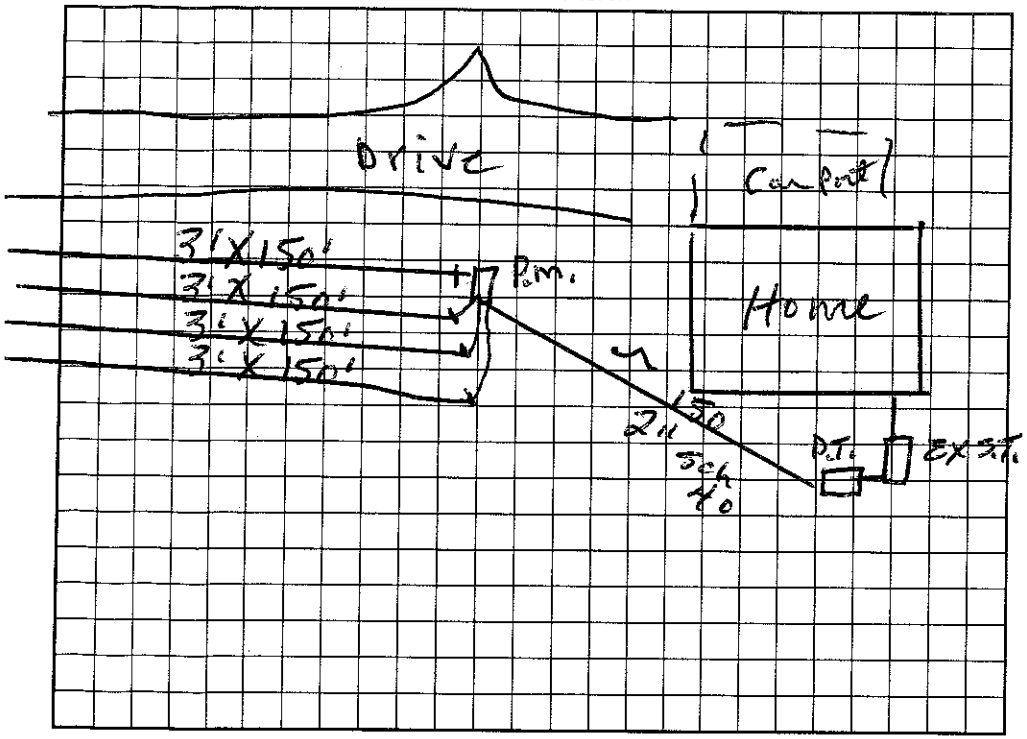

AS BUILT SKETCH

Permit can be suspended or revoked if any false information is supplied toward securing the permit/any unauthorized changes are made to the site/any unauthorized changes are made in the installation of the system. Improvement Permit with plat valid without expiration. Improvement Permit with site plan valid for sixty months. Authorization to Construct is valid for a period equal to that of Improvement Permit – not to exceed sixty months.

Signed: Ray D. Sigmon (Agent) date Installed by: Sigmons

Improvement Permit by: E. C. moore date 1-6-98 Operation Permit by: date

Authorization to Construct by: E. C. moore date 1-6-98 Existing System Inspection by: date

HEALTH DEPT. COPY: WHITE OWNER COPY (FINAL): YELLOW OWNER COPY (INITIAL): PINK