IREDELL COUNTY HEALTH DEPARTMENT

Statesville Phone TR 3-7271 Mooresville Phone NO 3-1271

PERMIT TO INSTALL SEPTIC TANK

Permit No. C. Lanier Elder Barnette Rt6 Permit Date Nov 8 1966

Owner R.V. Fox Address R 7

Installed By C Hoke Address R 7


Location of Property C/o Fox Paint Store -215- L off 70 E. onto Shiloh ch. Rd. 1st on left. 1 blk.

Tank		Capacity		Length of Lines		Fixtures	
Block	( )	1000	( )	225'	( )	No. of Baths	(3)
Precast	(+)	1250	( )	250'	( )	Dishwasher	( )
		1500	( )	Other 255		Garbage Grdr.	( )
		Other				Other	

NOTIFY HEALTH DEPARTMENT AT LEAST EIGHT HOURS BEFORE TANK IS TO BE INSPECTED.

Final Inspection 19 Approved ( ) Disapproved ( )

Remarks well 50' Bull tallow clay Very tight soil. Not the best of Layout (soil wise) Wooded!

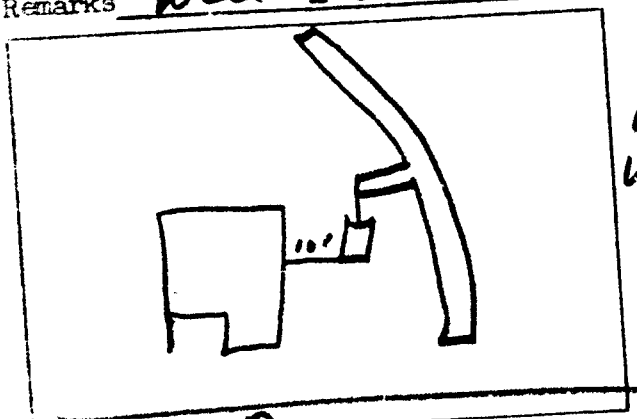

Sketch of Installation

Sanitarian