IREDELL COUNTY HEALTH DEPARTMENT - *ENVIRONMENTAL HEALTH* ☐ STATESVILLE OFFICE 704-878-5305 ☐ MOORESVILLE OFFICE 704-664-5281

IMPROVEMENT PERMIT / AUTHORIZATION TO CONSTRUCT / OPERATION PERMIT / EXISTING SYSTEM INSPECTION

PERMIT # REPAIR PIN # 4753-76-0153 DATE MAY 26, 2011

OWNER HARVEY HOLDINGS, INC APPLICANT: SAME PHONE: Home/Cell # Business # 704-929-0840

SITE ADDRESS 2088 SALISBURY HIGHWAY OWNER / APPLICANT ADDRESS 2088 SALISBURY HWY STATESVILLE, NC

SITE DIRECTIONS US 70 EAST, ON RIGHT AT BOX # 2088 (JUST PAST YELLOWSTONE LANE)

SUBDIVISION N/A BLOCK / SECTION N/A LOT # N/A LOT AREA 14.59 ACRES DESIGN FLOW 750 L.T.A.R. 0.30 GPD/FT2

Septic Tank EX Gallons: STB — Date

Pump Tank 1500 Gallons: PT 201 Date 8-19-08

Pump Make SQUARE D Model N-152 Serial # —

No. Nitrification Fields: 1 No. Lines 5 Linear Feet 625

Trench Width 36" Max. Trench Bottom Depth 36"

☐ New System ☑ Repair ☐ Expansion System Type I II III IV V VI

System Description:

Repair System Description: 25% REDUCTION, RISER MANIFOLD

Maintenance Agreement Required ☐ YES ☑ NO

Gravel Depth N/A ☐ GRAVITY ☑ PRESSURE

☐ Residence ☑ Business ☐ Other ☑ Slab ☐ Basement w/plumbing


No. Bedrooms No. Persons 30 No. Employees 30 ☐ Crawl Space ☐ Basement w/o plumbing

Water Supply: ☐ Private ☑ Public ☐ Community

Comments / Conditions ① INSTALL 25% REDUCTION SYSTEM ON CONTOUR AS SHOWN, REMOVE ANY EXISTING FILL PRIOR. ② SEE ATTACHED SHEETS FOR PUMP & PRESSURE MANIFOLD REQUIREMENTS.


SEE ATTACHED N.O.V.

INITIAL SITE SKETCH

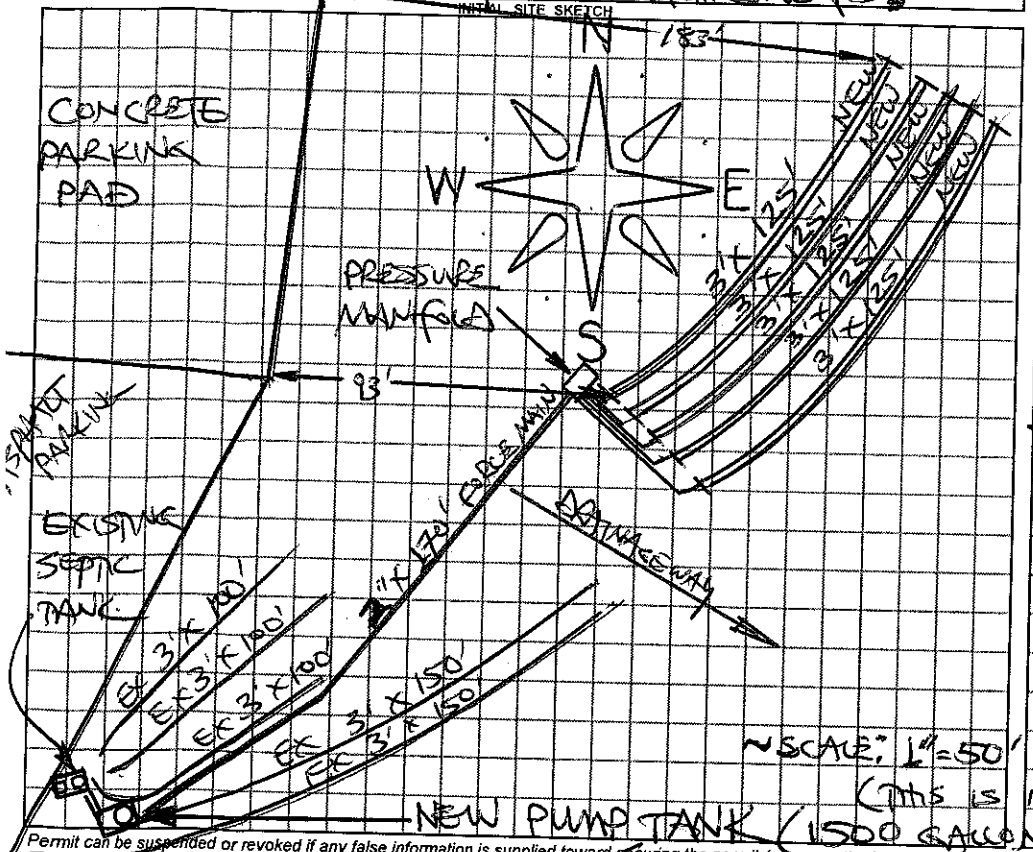

~SCALE: 1"=50'
(THIS IS NOT A SURVEY)

AS BUILT SKETCH

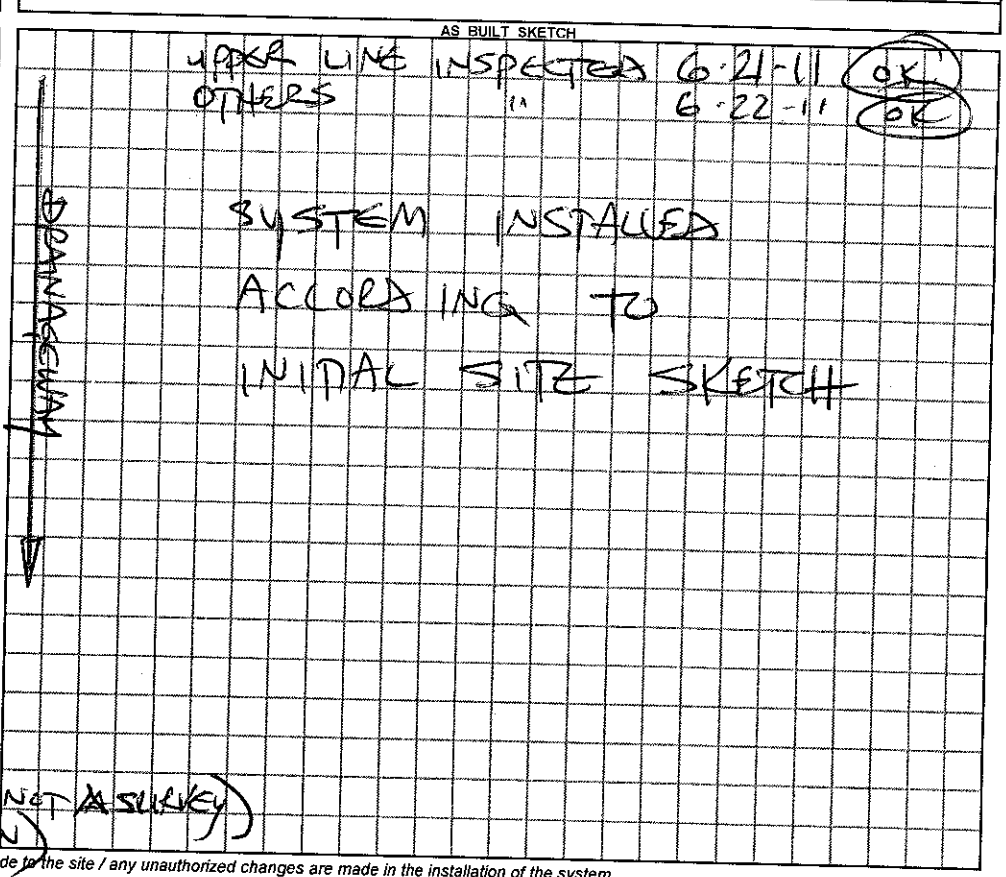

Permit can be suspended or revoked if any false information is supplied toward securing the permit / any unauthorized changes are made to the site / any unauthorized changes are made in the installation of the system.

☐ ***IMPROVEMENT PERMIT*** with plat valid without expiration. ☑ ***IMPROVEMENT PERMIT*** with ~~plat valid without expiration.~~ site plan valid 60 mo. ☑ ***AUTHORIZATION TO CONSTRUCT*** valid for period equal to IMPROVEMENT PERMIT--not to exceed 60 mo.

Owner / Applicant Signature: AMBAR WAUGH Date 5-26-11 Installed by: K & M GRADING

IMPROVEMENT PERMIT by: STEVE HEDRICK REHS Date 5-26-11 OPERATION PERMIT by: R. STEVE HEDRICK REHS Date 6-23-11

AUTHORIZATION TO CONSTRUCT by: STEVE HEDRICK REHS Date 5-26-11 Existing System Inspected by: REHS Date

YOU SHOULD CONTACT A LOCATOR SERVICE PRIOR TO ANY EXCAVATION

White Copy – Environmental Health YELLOW COPY (Final) Owner / Applicant PINK COPY (Initial) Owner / Applicant