HECTOR SANTIBANEZ

# IREDELL COUNTY HEALTH DEPARTMENT

THIS PERMIT REPLACES PREVIOUS ISSUED 11-25-2008

STATESVILLE 704-878-5305 MOORESVILLE 704-664-5281

## IMPROVEMENT PERMIT / AUTHORIZATION TO CONSTRUCT / OPERATION PERMIT / EXISTING SYSTEM INSPECTION

PERMIT # 153330 PIN # 4753-76-8023 DATE July 16, 2009

OWNER or APPLICANT JOEL POOLE, LLC PHONE: Business Home:

OWNER or APPLICANT ADDRESS 38 MOHAWK AVE, CORTE MADERA, CA

LOCATION / DIRECTIONS US 70 EAST, ON RIGHT BEFORE SHILOH ROAD AT BOX #2138

SUBDIVISION BLOCK / SECTION LOT # LOT AREA DESIGN FLOW 795 L.T.A.R. 0.25 GPD/FT²

Septic Tank 1500 Gallons: STB 528 Date 2-13-08

GREASE Pump TRAP (2) Gallons: ST 1012 Date 10-28-08

Pump Make Model GT 1007 Serial # 3-16-09

Nitrification Field No Fields 2 No Lines 8 Linear Feet 968

Trench Width 36" Max. Trench Bottom Depth 36" Gravel Depth N/A

☑ New System ☐ Repair ☐ Expansion System Type I II III IV V VI

System Description: 25% REDUCTION GRAVITY

Repair System Description: DRIP IRRIGATION

Maintenance Agreement Required ☐ YES ☑ NO

☑ GRAVITY ☐ PRESSURE

☐ Residence No. Bedrooms

☑ Business No. Persons

☐ Other No. Employees 2

☑ Slab ☐ Crawl Space

☐ Basement w/plumbing ☐ Basement w/o plumbing


Water Supply: ☐ Private ☑ Public ☐ Community

Comments / Conditions: GREASE TRAP FOR MEAT MARKET AND SEPTIC TANK FOR RETAIL FEED SYSTEM of 744 LF. GREASE TRAP FOR BAKERY FEEDS SEPARATE SYSTEM OF 225 LF

Comments / Conditions

INITIAL SITE SKETCH

AS-BUILT SKETCH

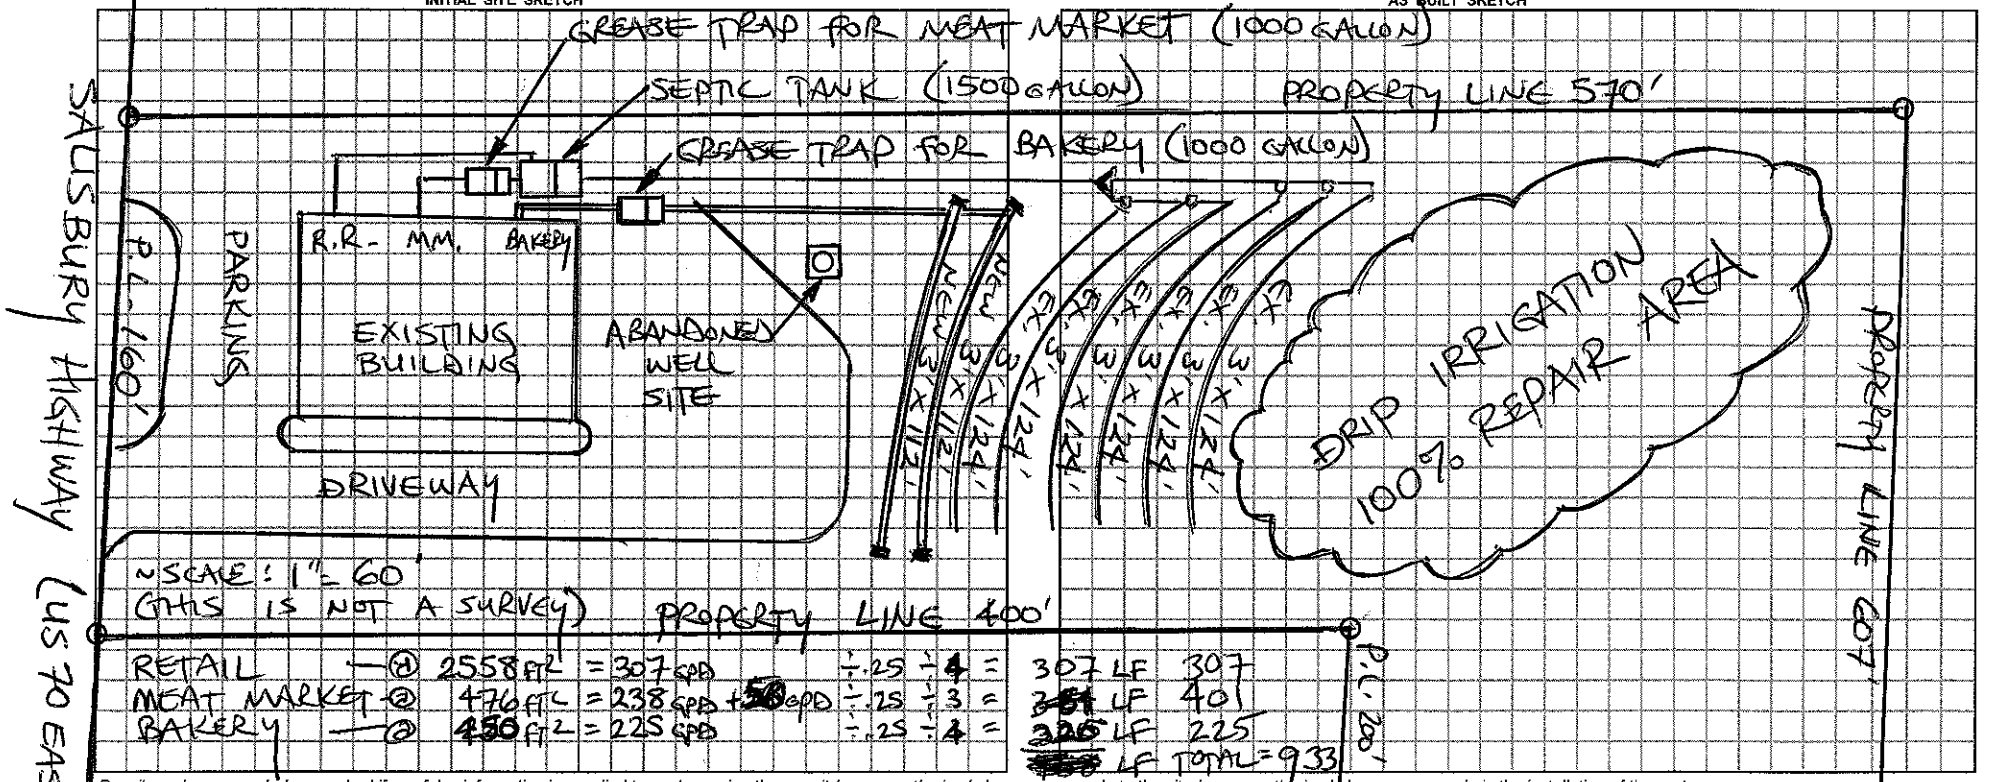


| | | | | | | |
|---|---|---|---|---|---|---|
| RETAIL | @ 2558 FT² | = 307 GPD | ÷ .25 | ÷ 4 | = 307 LF | 307 |
| MEAT MARKET | @ 476 FT² | = 238 GPD + 50 GPD | ÷ .25 | ÷ 3 | = 401 LF | 401 |
| BAKERY | @ 450 FT² | = 225 GPD | ÷ .25 | ÷ 4 | = 225 LF | 225 |
| | | | | | LF TOTAL = 933 | |

*Permit can be suspended or revoked if any false information is supplied toward securing the permit / any unauthorized changes are made to the site / any unauthorized changes are made in the installation of the system.*

☐ IMPROVEMENT PERMIT w / plat valid without expiration. ☑ IMPROVEMENT PERMIT w / site plan valid for 60 mos: 885 ☐ AUTHORIZATION TO CONSTRUCT valid for period equal to IMPROVEMENT PERMIT-not to exceed 60 mo.

Owner / Applicant Signature: Date 7-16-09

Improvement Permit by: STEVE HEDRICK Date 7-16-09

Authorization to Construct by: STEVE HEDRICK Date 7-16-09

Installed by: STEVE JORDAN

Operation Permit by: STEVE HEDRICK Date: 7-23-2009

Existing System Inspected by: Date:

***YOU SHOULD CONTACT A LOCATOR SERVICE PRIOR TO ANY EXCAVATION.***

WHITE COPY Environmental Health YELLOW COPY (Final) Owner / Applicant PINK COPY (Initial) Owner / Applicant